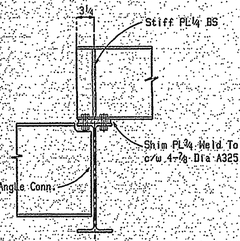

Section 1 E7

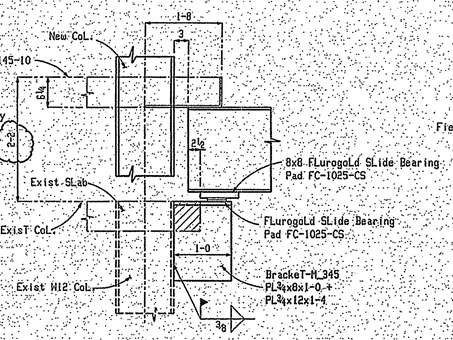

Section 2 E7

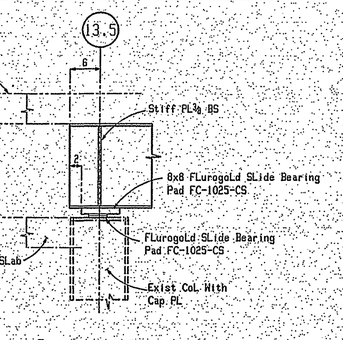

Section 3 E7

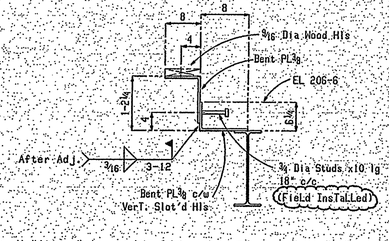

Section 4 E11

PLease Provide Locations on E11

TRO To Comment on E11 for Location

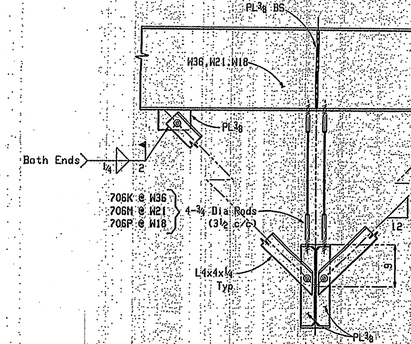

Section 5 E8

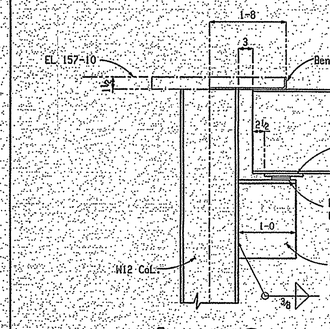

Section 6 E8

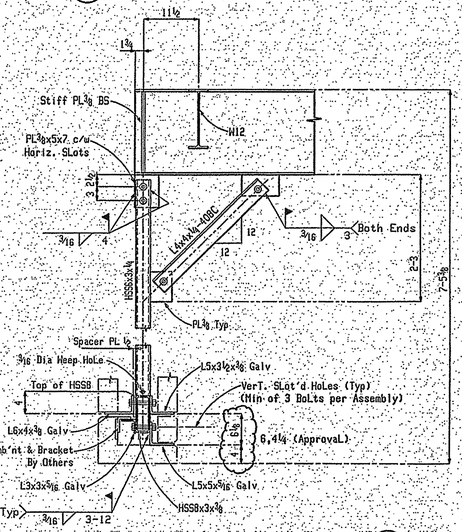

Section 7 E8

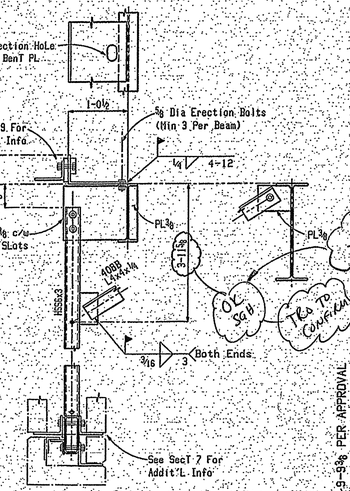

Section 8 E8

TRO To Verify Per Ref #65 Rel. Lr. El

OK To

OK SeAt

9-3 3/8 SecT 9
6-5 3/8 SecT 9
7-1 1/8 SecT 8B

PENDING RFI #33

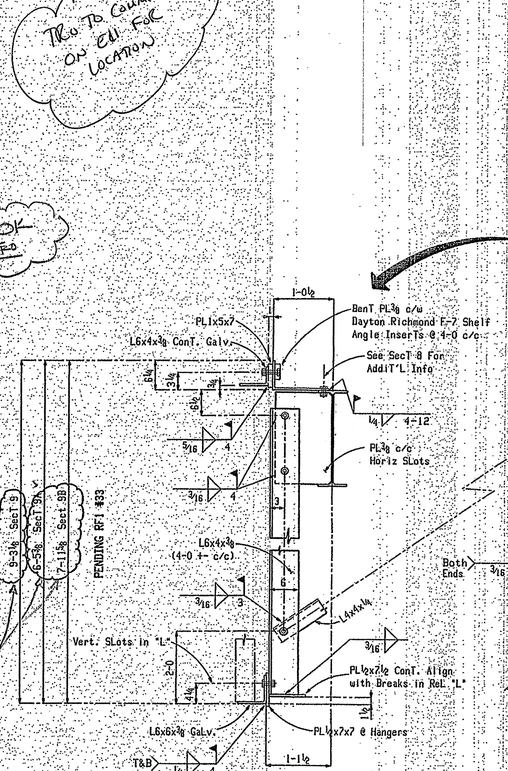

Section 9 9A 9B 9C E8

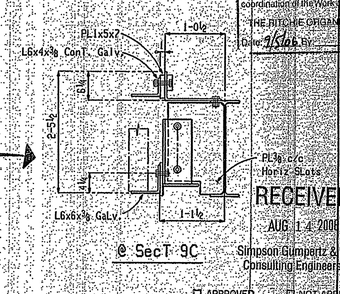

@ SecT 9C

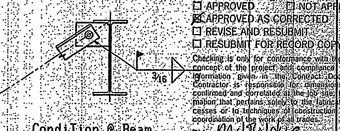


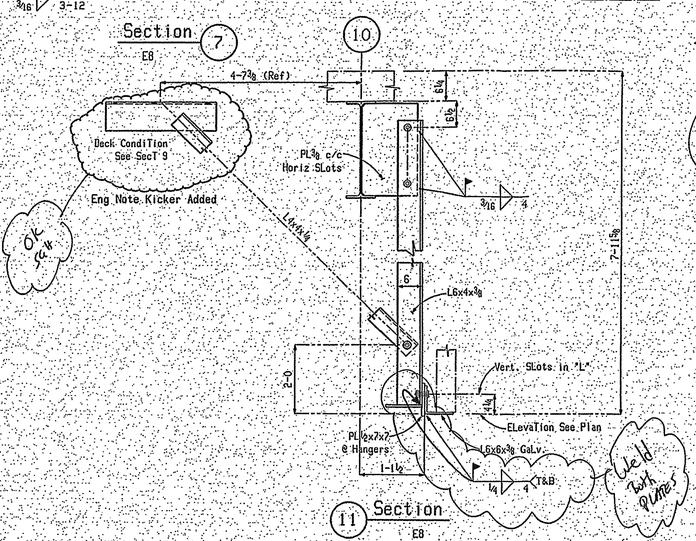

Section 10 E8

11 Section E8

Approved (✓) Approved as Corrected (✓) if checked above, fabrication MAY be undertaken. Approval does not authorize changes to Contract Sum unless stated in separate letter or Change Order.
If checked below, fabrication MAY NOT be undertaken. Resubmit corrected copies for final approval. Correction shall be limited to items marked.
Revise and Resubmit
Not Approved
Reviewed is only for conformance with the design concept of the project and compliance with the information given in the Contract Documents. The Contractor is responsible for dimensions; for information that pertains solely to the fabrication processes or to the means, methods, techniques, sequences and procedures of construction; and for coordination of the Work of all trades.

THE RITE-HITE ORGANIZATION
Date 7/26/06 By MD

RECEIVED
AUG 14 2006
Simpson Gumpertz & Heger Consulting Engineers Inc.

☐ APPROVED ☐ NOT APPROVED
☒ APPROVED AS CORRECTED
☐ REVISE AND RESUBMIT
☐ RESUBMIT FOR RECORD COPY

Checking is only for conformance with the design concept of the project and compliance with the information given in the Contract Documents. Contractor is responsible for dimensions to be confirmed and correlated at the job site; for information that pertains solely to the fabrication processes or to techniques of construction and for coordination of the work of all trades.

BY: MDWilder
DATE: 29 Aug 06
SIMPSON GUMPERTZ & HEGER INC.
CONSULTING ENGINEERS
41 SEYON ST., BLDG 1, SUITE 500
WALTHAM, MA 02453

FOR APPROVAL
AUG 31 2006
TRO

WILLIAM A. BERRY & SON, INC. REVIEWED IN ACCORDANCE WITH THE CONTRACT DOCUMENTS.
THE SUBCONTRACTOR / VENDOR IS RESPONSIBLE FOR ALL DIMENSIONS, CORRECT FIT AND COORDINATION OF ALL ITEMS TO BE FURNISHED & INSTALLED.
BY: MBK DATE: 8-9-06
JOB #: 04-310-0 JOB NAME: MMC-CHARLES ST.
SUBMISSION #: 05121-0020-2
SPEC./DRWG. REF.:
REVIEWED FOR CONSTRUCTABILITY

Revisions		
No.	Date	Description
1	31-07-06	UPDATED TO SUIT APPROVAL

NOVEL IRON WORKS
250 Ocean Road
Greenland, NH 03840

Project	Maine Medical Center.	Holes Dia(und)	Weld ERNOS
Description	SecTions & DeTails	AISC Certified Category III	
Architect	TRO	Drawn By	JD
Engineer	Simpson Gumpertz & Heger Inc.	Chk By	M.T.L.
Customer	William Berry & Son Inc.	Job No	316
		Sht No	E15