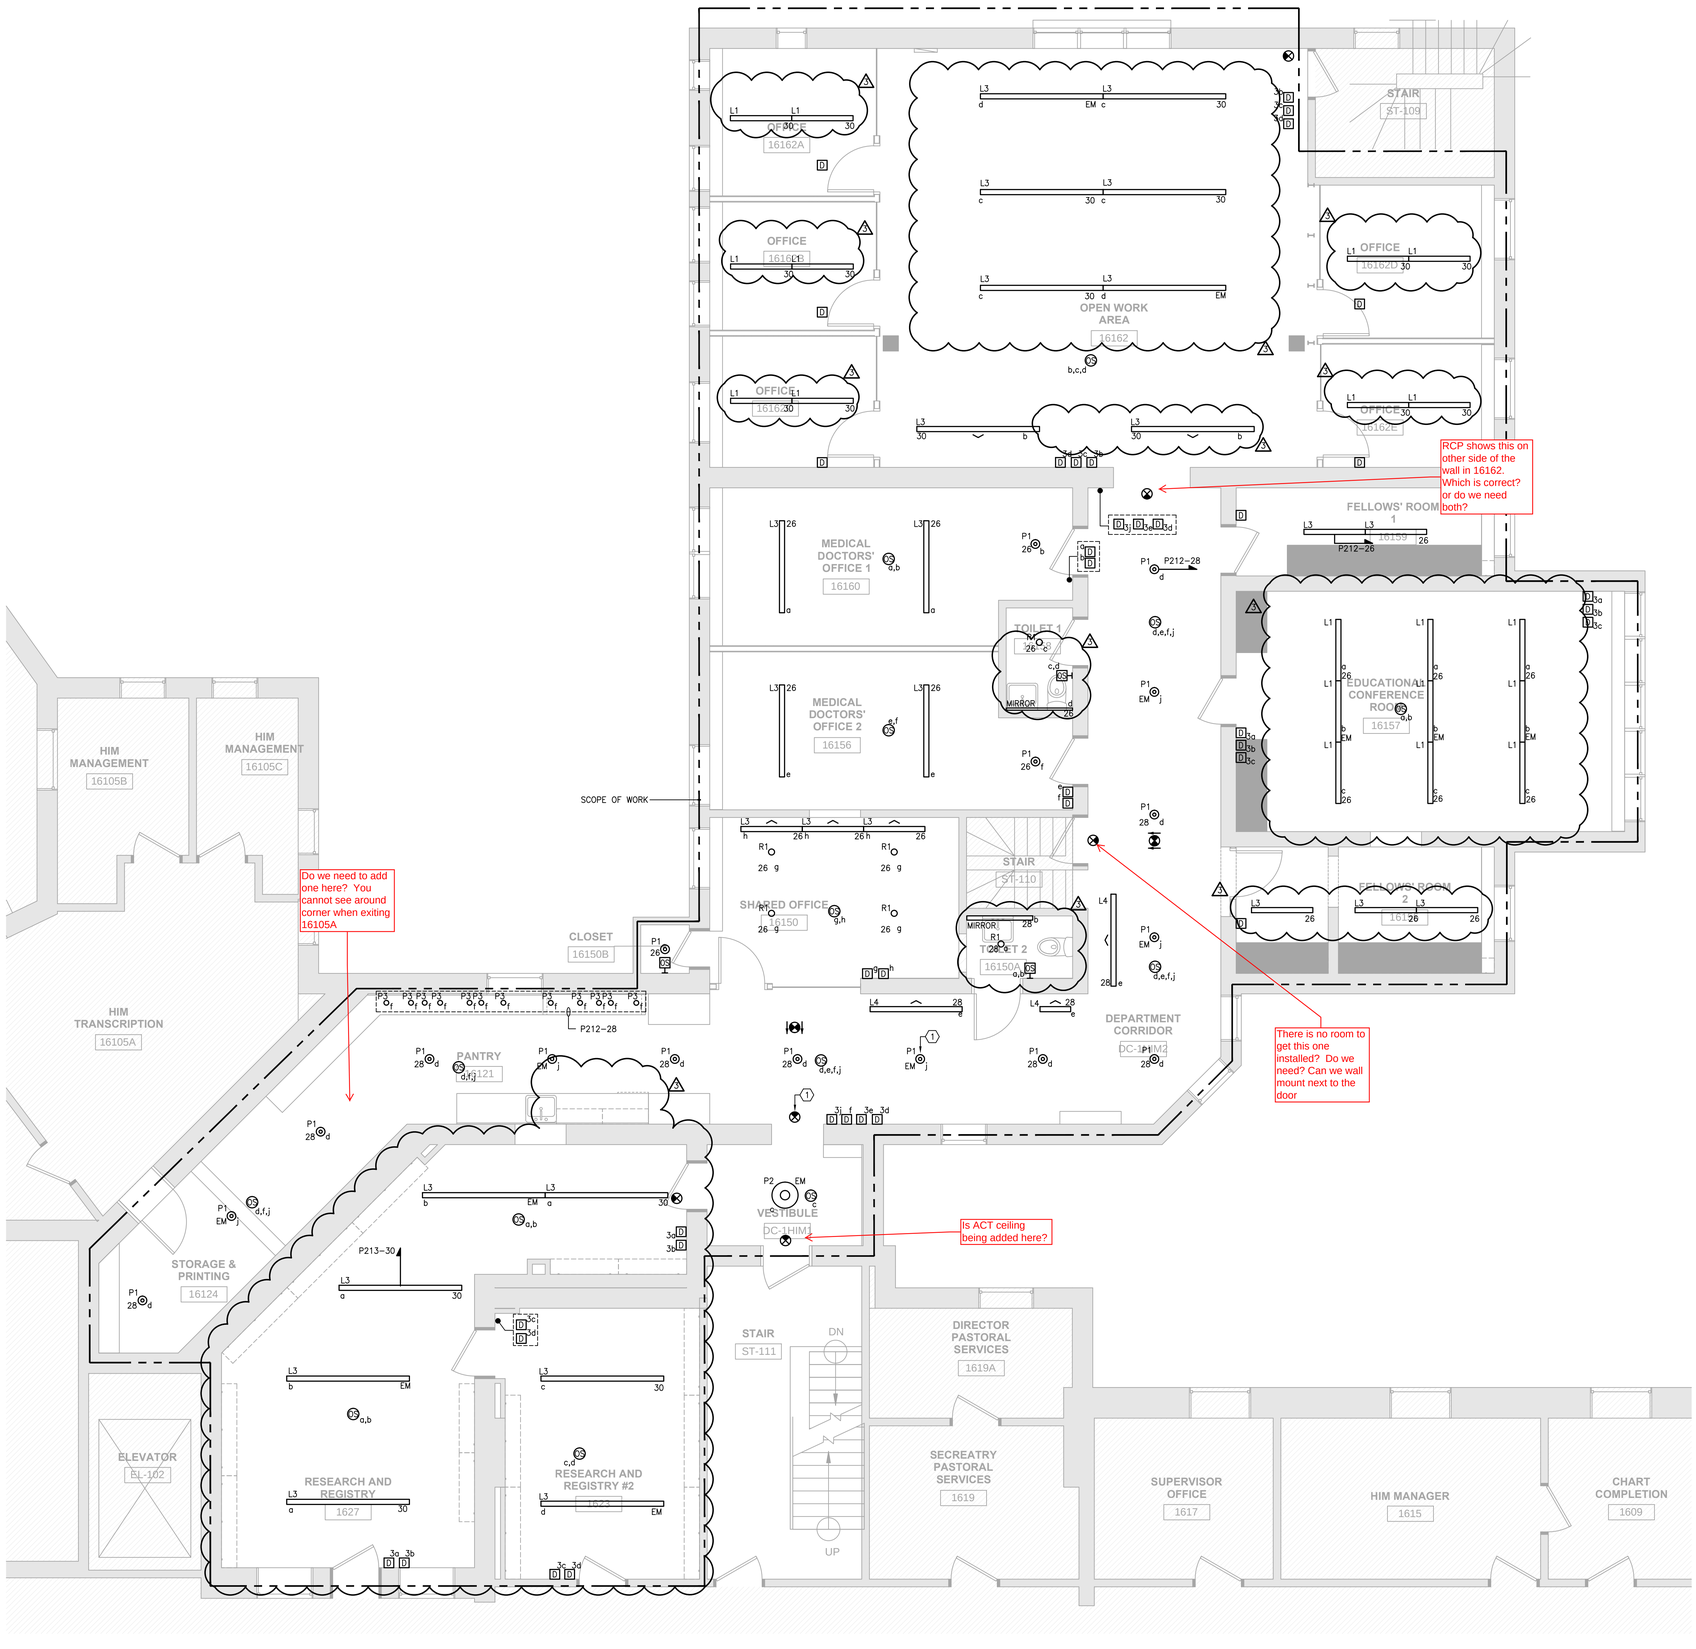

DRAWING NOTES:

1. REFER TO DRAWING E-000, E-500 AND E-501 FOR LEGEND, SYMBOLS, GENERAL NOTES AND SPECIFICATIONS.
2. ELECTRICAL CONTRACTOR SHALL COORDINATE NEMA RATINGS OF ALL DEVICES PRIOR TO INSTALLATION.
3. ELECTRICAL CONTRACTOR SHALL BE RESPONSIBLE FOR COORDINATING AND CONFIRMING LOCATIONS AND MOUNTING HEIGHTS OF ALL LIGHTING FIXTURES, SWITCHES AND ELECTRICAL DEVICES WITH ARCHITECT AND ARCHITECTURAL DRAWINGS.
4. CIRCUIT NUMBERS ARE SHOWN FOR DESCRIPTIVE PURPOSES ONLY. EXACT NUMBERS SHALL BE DETERMINED IN FIELD AND SHALL BE NOTED ON THE CONTRACTOR'S AS-BUILT DRAWINGS.
5. REFER TO DRAWING E-400 FOR LIGHTING FIXTURE SCHEDULE AND ARCHITECTUREAL RCP DRAWINGS FOR ADDITIONAL INFORMATION.
6. ALL OCCUPANCY SENSOR LOCATIONS ARE APPROXIMATE. REFER TO MANUFACTURERS INSTALLATION INSTRUCTIONS PRIOR TO INSTALLATION.
7. CONTRACTOR IS RESPONSIBLE FOR PROPER OCCUPANCY SENSOR SENSITIVITY AND TIME DELAY SETTINGS AND FIELD VERIFICATION OF CIRCUITS WITH RESPECT TO PROPER PLACEMENT.
8. ALL LIGHTING FIXTURES LOCATED IN ENCLOSED OFFICES, STORAGE ROOMS, UTILITY ROOMS, CONFERENCE ROOMS, ETC. SHALL BE CONTROLLED BY LOCAL DIMMER AND/OR SWITCHES VIA CEILING MOUNTED OCCUPANCY SENSORS OR WALL MOUNTED OCCUPANCY SENSORS.
9. PROVIDE COMMON FACE PLATE AND REQUIRED METAL INTERIOR BOX BARRIERS FOR ALL MULTIPLE GANG SWITCH LOCATIONS.

KEYED NOTES:

(1) CONNECT TO EXISTING EMERGENCY CIRCUIT SERVING AREA. TYPICAL FOR ALL FIXTURES DESIGNATED AS EMERGENCY AND EXIT SIGNS. ALL SWITCHED EMERGENCY FIXTURES SHALL BE POWERED VIA AN EMERGENCY BYPASS RELAY.

PERKINS + WILL
225 Franklin Street, Suite 1100
Boston, MA 02110
t 617.478.0300
f 617.478.0321
www.perkinswill.com

CONSULTANTS
MEPFP
AKF GROUP LLC
99 Bedford St., 2nd Floor
Boston, MA 02111
t 617.737.1111
f 617.737.4311

PROJECT
ACCU RELOCATION
22 Bramhall Street
Portland, Maine 04102

Maine Medical Center
MaineHealth

MAINE MEDICAL CENTER
22 Bramhall Street
Portland, Maine 04102

ISSUED FOR CONSTRUCTION
05/02/2016

ISSUE CHART

NO	ISSUE	DATE
3	ASI 001	6/29/2016
2	ADDENDUM 1	5/9/2016
1	ISSUED FOR BID	5/3/2016

Job Number B160089-000
Checked
Approved

TITLE
ELECTRICAL FLOOR PLAN - LIGHTING

SHEET NUMBER
E-200

SAVE DATE: 6/29/2016 6:01 PM
PLOT DATE: 6/29/2016 6:01 PM
LOGIN: Roy, Adam
\\terminalsrv\Projects3_Projects\B160000\B160089-000\D-Design Mgmt\CAD\MC\B\Elec\B160089-000_E-200.dwg