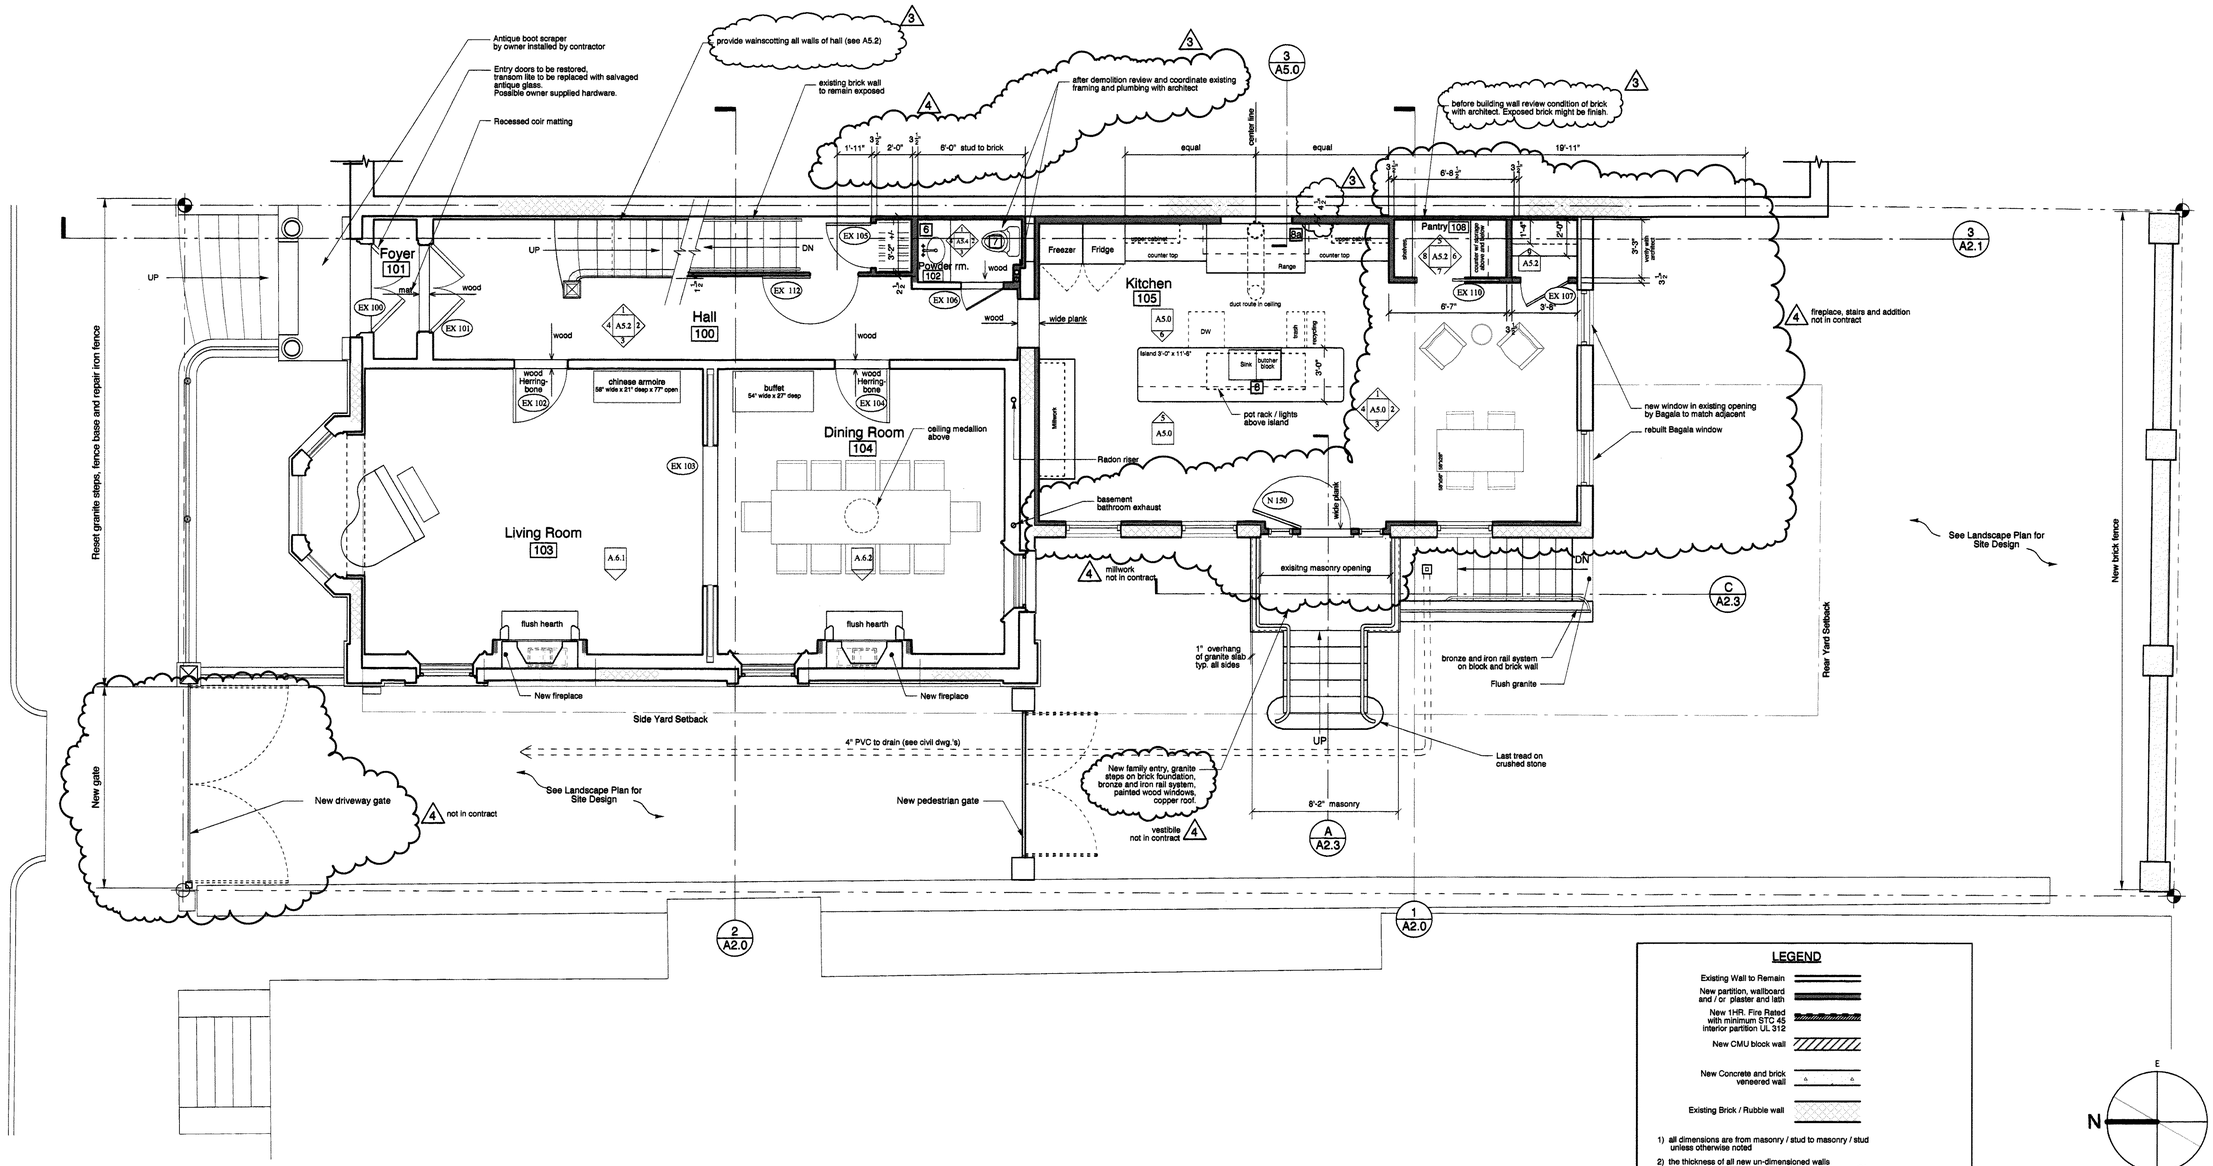

First Floor Plan

SCALE: 1/4" = 1'-0"

These drawings are the architect's instruments of service. A substantial amount of work to be done on the project is based on conversations between the Architect and Wright-Ryan Construction. If the drawings are used without the Architect's involvement in interpretation of the documents and review of field conditions, the Architect shall not be liable for problems with any aspect of the design during and after construction.

construction set 01/03/11

Van Dam Architecture and Design

66 West Street
Portland, Maine 04102
207-773-0443
FAX 772-2892
studio@vandamdesign.com

Landscape Architect:
James Doyle Design Associates
125 Greenwich Avenue
Greenwich, CT 06830

Structural Engineer:
Becker Structural Engineers Inc.
75 York Street
Portland, ME 04101

Jenkins Residence

294 Spring Street
Portland, Maine

First Floor Plan

A1.1

Drawn by: JPR/PM/KRH Scale: 1/4" = 1'-0" Date: 11/22/10

Revisions: 1 01/03/11 2 04/06/11 Job #: 20913