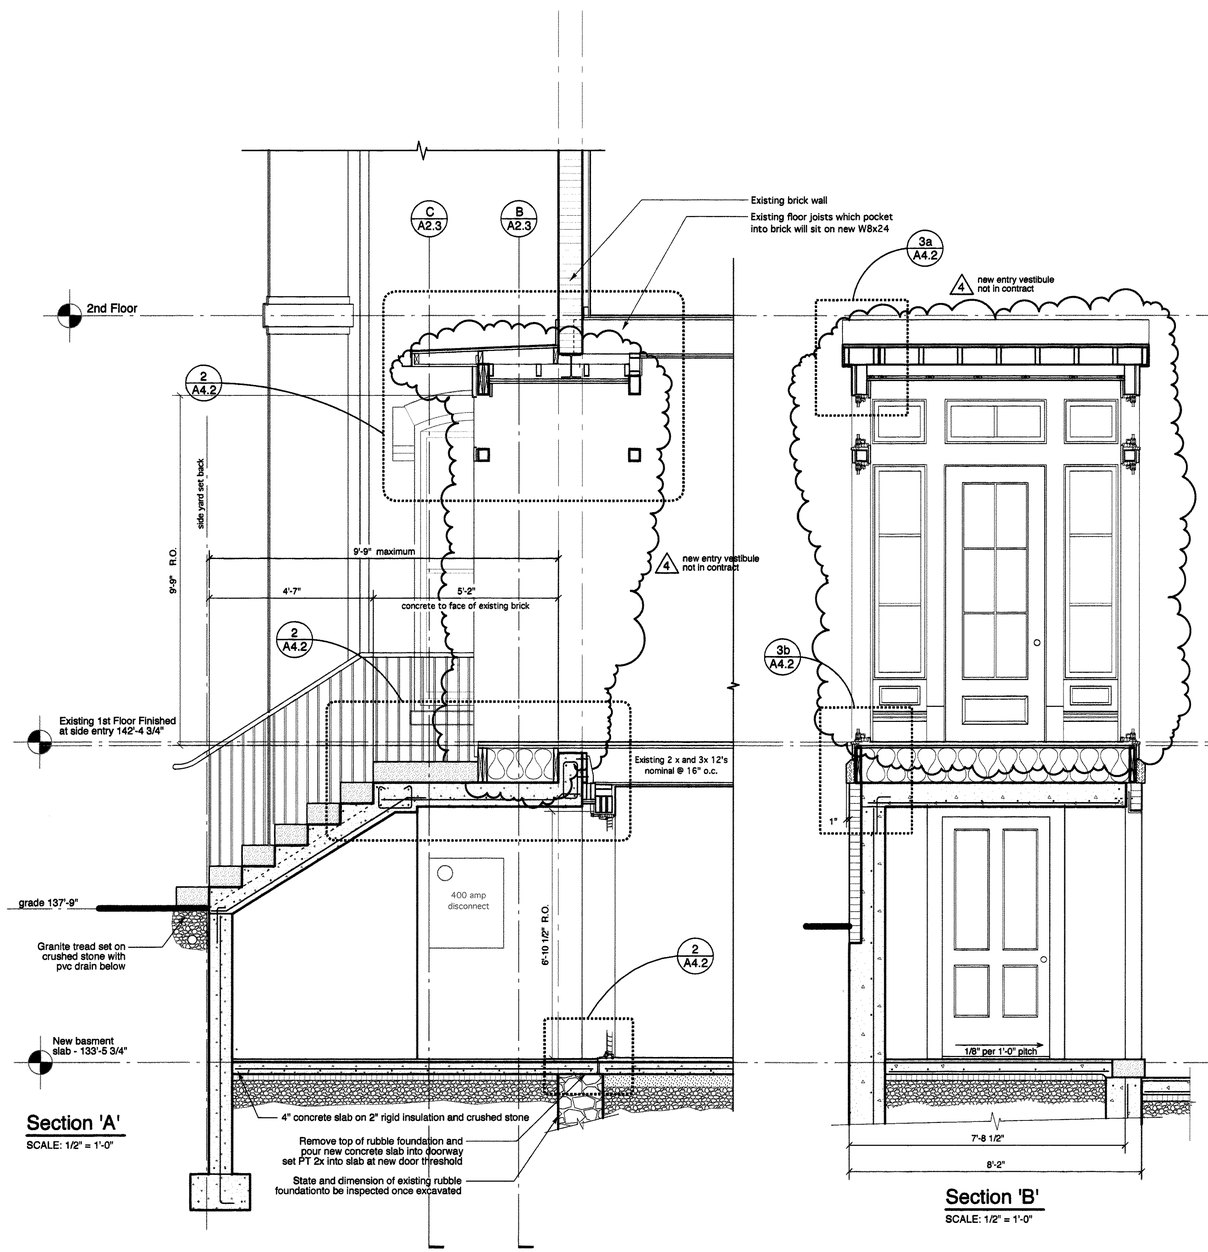

Section 'A'

SCALE: 1/2" = 1'-0"

Section 'B'

SCALE: 1/2" = 1'-0"

Section 'C'

SCALE: 1/2" = 1'-0"

3 Entire Sheet

These drawings are the architect's instruments of service. A substantial amount of work to be done on the project is based on conversations between the Architect and Wright-Ryan Construction. If the drawings are used without the Architect's involvement in interpretation of the documents and review of field conditions, the Architect shall not be liable for problems with any aspect of the design during and after construction.

construction set 01/03/11

Van Dam Architecture and Design

66 West Street
Portland, Maine 04102
207 775-5043
FX 775-2892
studio@vandamdesign.com

Landscape Architect:
James Doyle Design Associates
125 Greenwich Avenue
Greenwich, CT 06830

Jenkins Residence

294 Spring Street
Portland, Maine

Sections Details

A2.3

Drawn by: JPR | Scale: 1/2" =1'-0" | Date: 14 April 2010

Revisions: - 1 01/03/11 4 04/06/11 | Job #: 20913