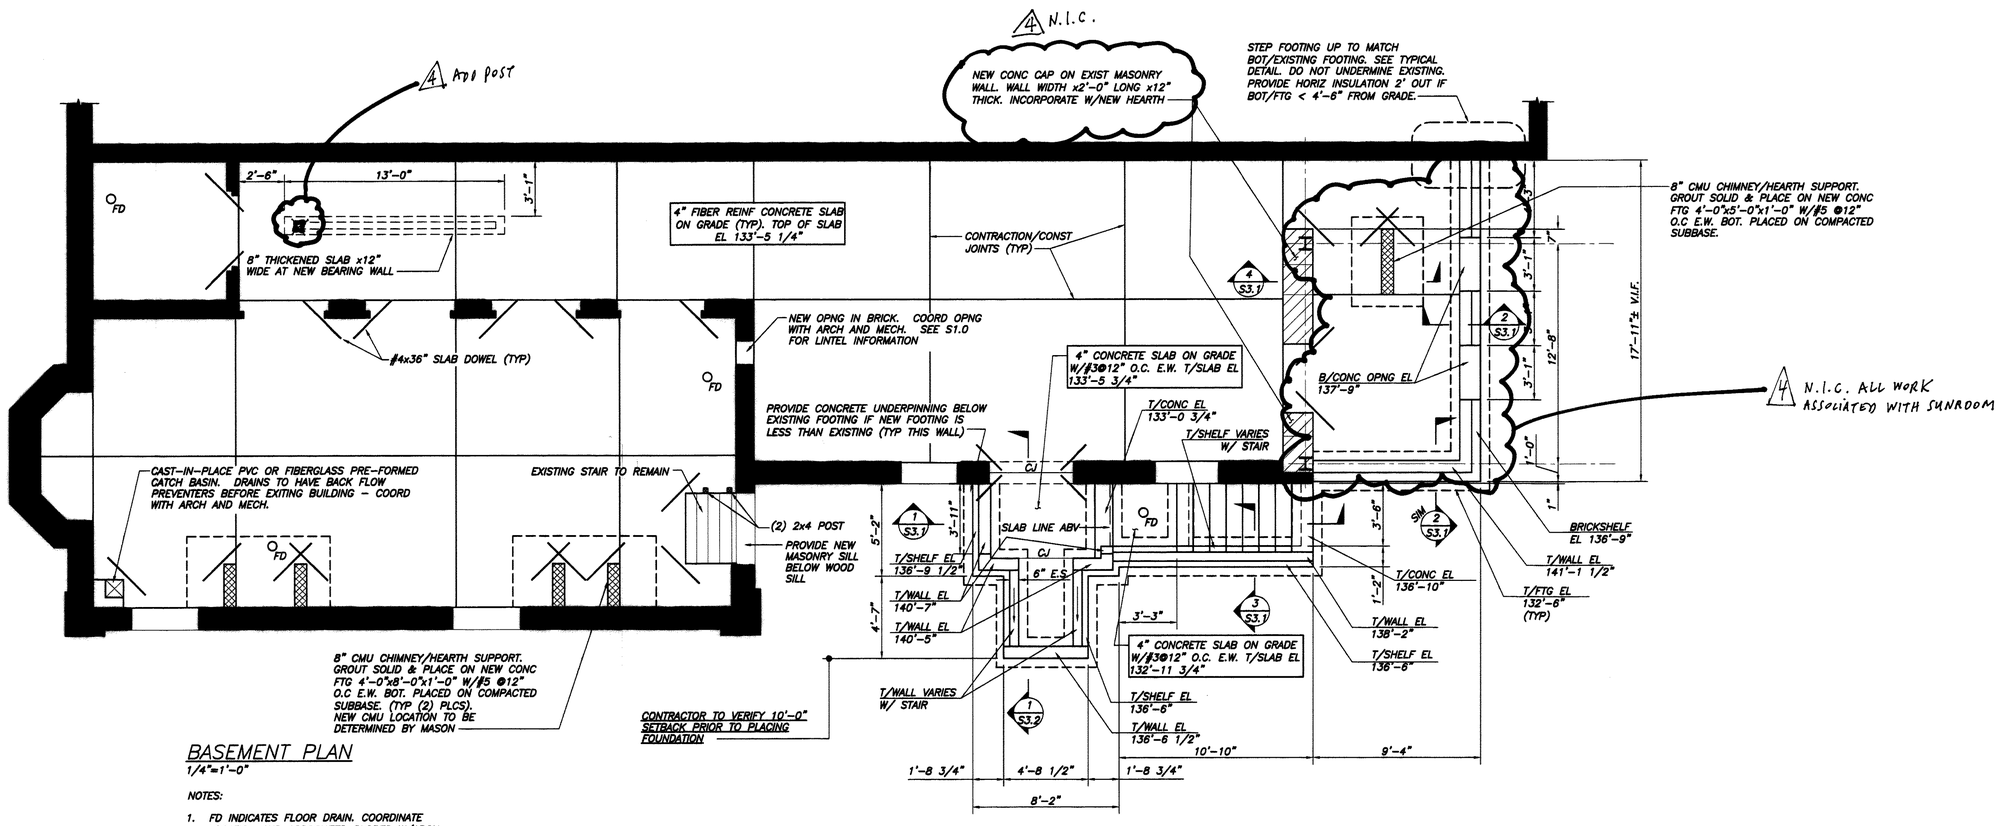

BASEMENT PLAN

1/4"=1'-0"

NOTES:

1. FD INDICATES FLOOR DRAIN. COORDINATE LOCATION AND ASSOCIATED SLOPES W/ARCH.

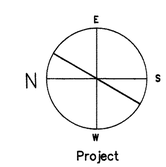

These drawings are the architect's instruments of service. A substantial amount of work to be done on the project is based on conversations between the Architect and Wright-Ryan Construction. If the drawings are used without the Architect's involvement in interpretation of the documents and review of field conditions, the Architect shall not be liable for problems with any aspect of the design during and after construction.

Van Dam Architecture and Design
66 West Street
Portland, Maine 04102
207-775-0443
FAX 207-775-0302
studio@vandamdesign.com

BECKER structural engineers, inc.
75 York Street
Portland, ME 04101-4701
Tel 207-879-1838
Fax 207-879-1822
www.beckerstructural.com
info@beckerstructural.com

Landscape Architect:
James Doyle Design Associates
125 Greenwich Avenue
Greenwich, CT 06839

Jenkins Residence

294 Spring Street
Portland, Maine

Basement Plan

S1.1

Drawn by: APP Scale: NOTED Date: 21 September 2010
Revisions: A 04/26/11 Job #: 20913