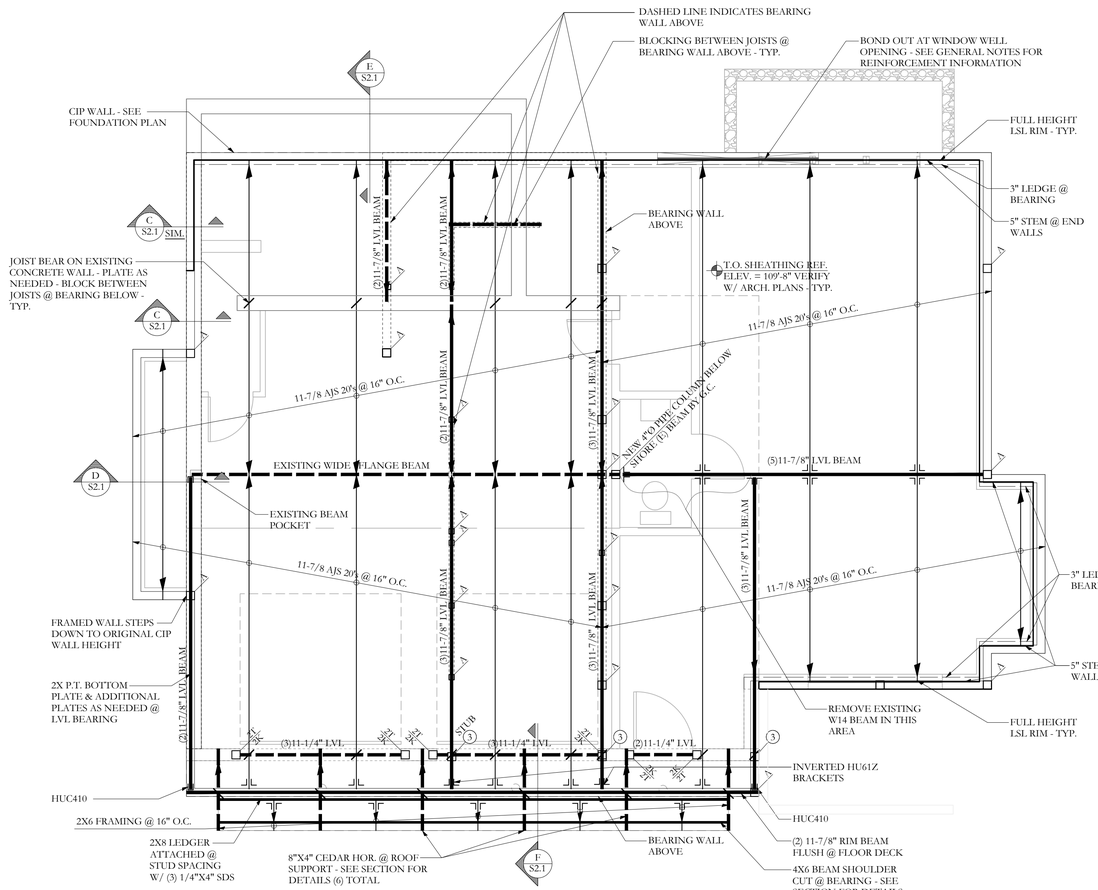

FRAMING PLAN SYMBOLS KEY	
□	WOOD POST
○	STEEL COLUMN
(X)	NUMBER OF WOOD STUDS IN POST BELOW
A	COLUMN ABOVE THIS LEVEL
C	COLUMN CONTINUOUS THROUGH THIS LEVEL
/E/	EXISTING COLUMN BELOW
	JOIST BEARING
	CONTINUOUS JOIST WITH INTERMEDIATE BEARING
	FLUSH FRAMED JOIST BEARING WITH HANGER
	WOOD STUD BEARING WALL BELOW
	SHEAR WALL
"XT"	NUMBER OF TRIM STUDS UNDER HEADER
"XK"	NUMBER OF KING STUDS ADJACENT TO HEADER

FIRST FLOOR/LOW ROOF FRAMING PLAN

0' 1' 5' 10'

SCALE 1/4"=1'-0"

NOTES:

1. SEE S1 FOR GENERAL STRUCTURAL NOTES.
2. ALL SHEATHING TO BE 5/8" MIN. - SEE GENERAL NOTES FOR ADDITIONAL INFORMATION.
3. ALL WOOD COLUMNS IN 2x6 WALLS SHALL BE 3-2x6 AND IN 2x4 WALLS SHALL BE (3) 2x4, UNO.
4. ALL WOOD BEAMS ARE FLUSH, UNO.
5. ~~ALL HEADERS ARE (2)-2x6 UNO.~~
6. ALL FLOOR JOISTS TO BE 11 7/8" AJS 20's @ 16" O.C. BY BOISE CASCADE OR EQUAL UNO

2

MARK MUELLER ARCHITECTS A.I.A.
100 Commercial Street
Suite 205
Portland, Maine 04101
Phone: 207.774.9057
Fax: 207.773.3851
Email: mark@muellerarchitects.com

©COPYRIGHT MUELLER ARCHITECTS, LLC

ANSEL RESIDENCE

11 ORCHARD STREET
PORTLAND, MAINE

RENOVATIONS OF:

FIRST FLOOR/
LOW ROOF FRAMING PLAN

REVISIONS	DATE
1: Jan 28th, 2015 FOR PRICING 2: Jan 28th, 2015 CITY REVIEW COMMENTS	Jan. 28th, 2015

PROJECT: ANSEL RESIDENCE
DRAWN BY: WMc
CHECK BY: ACJ

Structural Integrity
Consulting Engineers, Inc.
77 Oak Street
Portland, ME, 04101
p. 207-774-4644
f. 866-793-7835
www.structuralinteg.com

STATE OF MAINE
AARON C. JONES
No. 10968
LICENSED PROFESSIONAL ENGINEER
02/20/15

BUILD WITH CONFIDENCE
©2014 Structural Integrity Consulting Engineers, Inc.

SI# 14-0225

S1.2