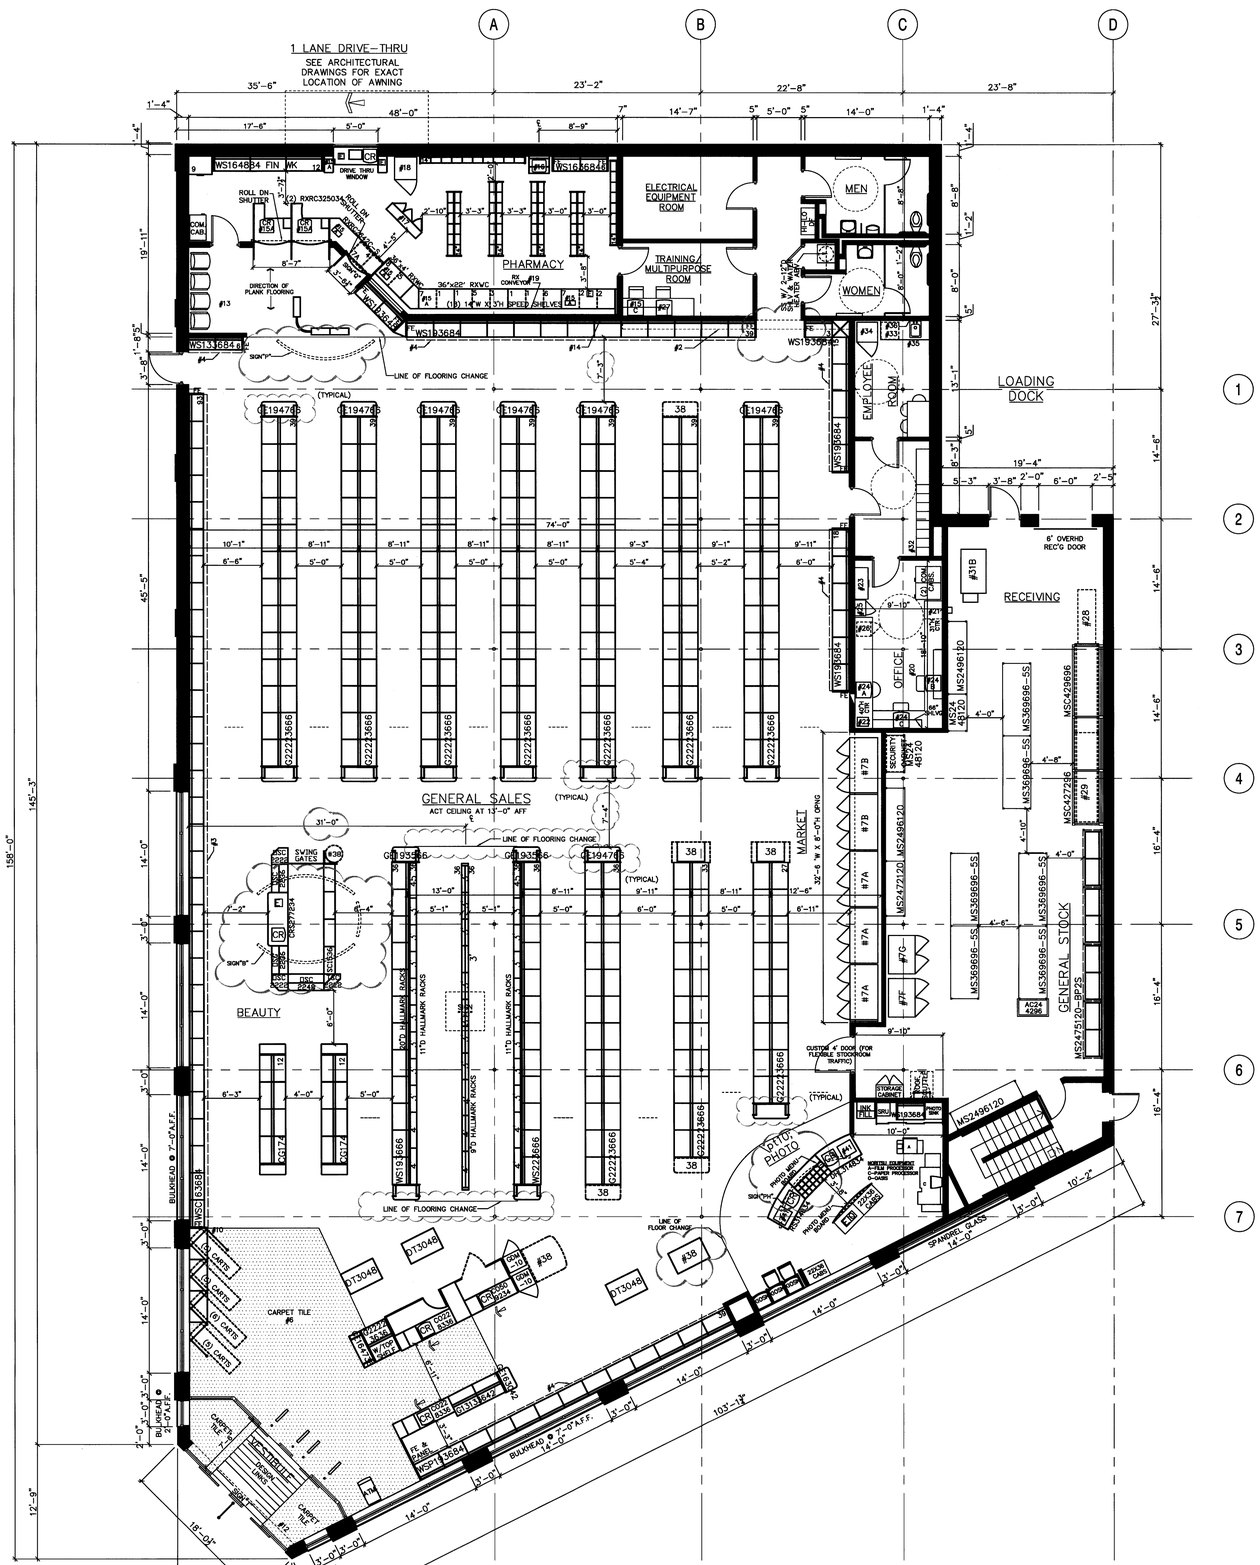

11/17/08 (D106) REMOVE #12, E.A.S. SYSTEM AT RESTROOM CORRIDOR PER LOSS PREVENTION; REVISE SSFE TO FE; ADD NEW PEPSI VENDOR DUMP TABLE; ADD BEAUTY SIGNS CENTERED OVER COSMETIC BULLPEN;UPDATE INTERIOR HANGING SIGN NOTES;REVISE LOCATION OF PHOTO MENU BOARD; UPDATE WALGREEN TITLEBLOCK SCRIPT; REVISE ROLLING GONDOLA ENDS TO STANDARD GONDOLA ENDS; ADJUST BACK & MIDDLE AISLE SPACING ACCORDINGLY.

08/20/08 (D108) FLIP FLOP LOCATIONS OF OFFICE AND ELECTRICAL ROOM PER PROJECT ARCHITECT.

08/13/2008 (D104) PER PROJECT ARCHITECT: ADJUST BASE PLAN TO MATCH OUTSIDE ARCHITECT'S PLAN. SHOW BASEMENT STAIRWAY PER PROJECT ARCHITECT. ADJUST FRONT WALL ANGLE TO ACCOMODATE SLIGHT CHANGE PER OUTSIDE ARCHITECT'S DRAWING. ADD AS BUILT COLUMN LOCATIONS. CHANGE WALK IN COOLER/FREEZER TO REMOTE COMPRESSOR TEL/TEM REACH IN UNITS PER COLUMN INTERFERENCE NOT PREVIOUSLY ADDRESSED BY OUTSIDE ARCHITECT. SHOW BACK UP COOLER/FREEZERS IN STOCKROOM AND ADJUST STOCKROOM SHELVING. LOWER PHARMACY WINDOW SILL; ADJUST WALL SHELVING & REMOVE VERIFICATION SHELF; REVISE SIGN "M" TO READ DROP OFF/PICK UP; ADD CEILING HEIGHT BELOW GENERAL SALES; ADD MOUNTING HEIGHT TO MENU BOARD; REMSE AISLE MARKER MOUNTING HEIGHT TO BE CONSISTANT WITH BULLETIN UPDATE DHL DUMP TABLE. ENLARGE ELECTRICAL ROOM.

05/07/08 (D103) PER PROJECT ARCHITECT: SHOW NEW PHOTO LAYOUT AND REMOVE SOFFIT. ADJUST SHELVING AND GONDOLA'S IN PHOTO AREA AS NECESSARY.

02/06/08 (D102) STORE OPERATIONS SIGN OFF: SHOW PROTOTYPE FULL COSMETICS DEPARTMENT PER DEMOGRAPHICS DETERMINED BY STORE OPERATIONS. SHOW LARGER AISLE FOR PROMO AISLE IN FRONT HALF OF STORE. ENLARGE SALES/STOCK DOOR TO ACCOMODATE EASIER TRANSPORTATION OF MERCHANDISE FROM STOCK TO SALES. UPDATE RX INSERTS AND COUNTERS TO MATCH LATEST PROTOTYPE. ADD DHL

12/04/07 (D101) JS NO SHOW WINDOWS PER PROJECT ARCHITECT. SHOW VESTIBULE PER SNOWFALL CLIMATE DATA. PLAN REVIEWED AND APPROVED BY MERCHANDISER MIKE ULASZEK ON 12/06/07. AWAITING EXECUTIVE APPROVAL.

INTERIOR HANGING SIGNS

GENERAL SALES AREA:
ALL SIGNS @ 10'-8" TO BOTTOM OF SIGN UNLESS OTHERWISE NOTED.
AISLE MARKERS @ 9'-6" TO BOTTOM OF SIGN.

SIGN "B" BEAUTY SIGN (9'-4" TO BOTTOM OF SIGN)
SIGN "L" LIQUOR / THANK YOU
SIGN "PH" PHOTO SIGN (9'-4" TO BOTTOM OF SIGN)
SIGN "T" STORE HOURS SIGN
SIGN "GC" GREETING CARD SIGN
SIGN "D" DOWNTOWN CHECKOUT LANE #
SIGN "CA" CALIFORNIA ACCESSIBILITY SIGN (8'-0" TO BOTTOM OF SIGN)
SIGN "ADA" SYMBOL OF ACCESSIBILITY

PHARMACY DEPARTMENT:
REFER TO FIXTURE PLAN FOR REQUIRED SIGNS
SIGN "J" PICK UP SIGN
SIGN "K" DROP OFF SIGN
SIGN "M" DROP OFF / PICK UP SIGN
SIGN "P" PHARMACY SIGN (9'-4" TO BOTTOM OF SIGN)
SIGN "Q" CONSULTATION WINDOW
SIGN "TX" T. A. S.
ATTACH SIGNS TO UNDERSIDE OF CASED OPENINGS. REFER TO FIXTURE PLAN FOR SIGN LOCATION.
PROVIDE (2) HOLLOW WALL ANCHORS PER SIGN.
SCREW THREADED EYEBOLT INTO ANCHOR. HANG SIGNS FROM EYEBOLTS WITH "S" HOOKS.

GENERAL NOTES

GENERAL SALES AREA:
1. PLEASE PROVIDE PROPER A.D.A. CLEARANCES ON BOTH SIDES OF ALL DOORS
2. MIRROR ON REAR WALL
3. BEAUTY CORNICE
4. SALES AREA CORNICE (FIXTURE MOUNTED)
5. PHOTO CORNICE (FIXTURE MTD UNLESS NOTED)
6. CARPET TILES & DESIGN LINKS FURNISHED AND INSTALLED BY WALGREENS (WHEN SHOWN)
7. MASTER-BILT REACH-IN REFRIGERATION:
   MODEL TEM - ENDLESS REACH-IN REFRIGERATORS AND MODEL TEL - ENDLESS REACH-IN FREEZERS (ADD 2" AT EACH END, FOR END PANELS)
   A. (3) TEM-3-24: 74 1/4"W X 37 3/4"D X 80"H
   B. (2) TEL-3-24: 74 1/4"W X 37 3/4"D X 80"H
   BMG/BLG SERIES - SELF CONTAINED REFRIGERATORS AND FREEZERS
   C. __ BMG-74: 78"W X 35 3/8"D X 79"H
   D. __ BLG-74: 78"W X 35 3/8"D X 79"H
   SMB SERIES - SELF CONTAINED SLIDING DOOR REFRIGERATORS
   E. __ SMB-580: 70"W X 32 1/4"D X 75 1/2"H
   BACK-UP REFRIGERATORS AND FREEZERS
   F. (1) TAC-48HD: 52"W X 35 3/4"D X 80 1/2"H
   G. (1) TAF-48HD: 52"W X 35 3/4"D X 80 1/2"H
8. MASTER-BILT WALK-IN COOLER: PROVIDE
   ( ) #1000R COOLMASTER DOORS 26 3/4" X 73" EACH AND
   ( ) #100FR FREEZEMASTER DOORS 26 3/8" X 73" EACH BY ANTHONY
   A. __ DOOR(S): FOR EACH DOOR PROVIDE (7) __"D BEV-O-FLOW GRAVITY SHELVES; UPPER (5) WITH SLIDES AND LOWER (2) WITH ROLLERS COMPLETE WITH UPRIGHTS
   B. ( ) DOOR(S): FOR EACH DOOR PROVIDE 36"D B-O-F NYLA-LITE SHELVING SYSTEM
   C. __ DOOR(S): __"D ROLLER CONVEYOR AT FLOOR LEVEL
   D. ( ) DOOR(S): FOR EACH DOOR PROVIDE 27"D ANTHONY SHELVES
   E. __ DOOR(S): FOR EACH DOOR PROVIDE (2) 27"D ANTHONY SHELVES AND (4) 36"D MERCHANDISER SHELVES
   F. __ DOOR(S): __"D DOUBLE DECK ROLLER CONVEYOR
9. ICE CHEST BY VENDOR
10. CART RAILS W/ DISPLAY SHELF & SLAT WALL ABOVE
11. PROVIDE A 6"H BLACK VINYL BASE AT ALL CHECKOUTS
12. ELECTRONIC ARTICLE SURVEILLANCE SYSTEM

PHARMACY DEPARTMENT:
13. PATIENT SEATING AREA: (4) SEATS & TRAFFIC CONTROL FIXTURE
14. PROVIDE FRAMING FOR 3'-6"W X 7'H OPENING FOR FUTURE DROP-OFF WINDOW
15. COMPUTER TERMINAL
    15A: INTERCOM PLUS TERMINAL
    15C: TRAINING TERMINAL (IN TRAINING ROOM)
16. RX SINK AND CABINET
17. CRX CABINET W/ LAMINATED PANEL SURROUND
18. RX REFRIGERATOR
19. PROVIDE A CARPETED FLOOR WITH RUBBER RUNNERS. RX UNDERCOUNTER INSERTS:
    #1 - RX 3 DRAWER VIAL INSERT
    #2 - RX 3 DRAWER FILE INSERT
    #3 - RX OPEN INSERT
    #4 - RX CONSULTATION COUNTER UNIT
    #5 - RX PRINTER INSERT
    #6 - RX 5 DRAWER FILE INSERT
    #7 - RX OPEN INSERT WITH CPU SHELF (39"H CNTR)
    #7A-RX OPEN INSERT WITH CPU SHELF (34"H CNTR)
    #8 - RX OPEN CABINET (39"H CNTR)
    #9 - RX 10 DRAWER FILE CABINET

OFFICE:
20. PROVIDE TILED FLOOR & VINYL WALLCOVERING
21. UNDER COUNTER SHELF UNIT
22. PRINTER
23. LATERAL FILE
24. OFFICE COMPUTERS
    24A: P.O.S. TERMINAL
    24B: AS400 TERMINAL
    24C: OFFICE P.C.
25. TILL LOCKER
26. SAFE
27. TV & VCR (IN TRAINING ROOM)

STOCKROOM:
28. NEST-A-FLEX CONVEYOR
29. GRAVITY CONVEYOR
30. POWER ROLLER CONVEYOR
31. SEE ARCHITECTURAL DRAWINGS FOR EXACT LOCATION & POSITIONING OF COMPACTORS
    31A: TRASH COMPACTOR
    31B: BALER
    31C: CARDBOARD COMPACTOR

EMPLOYEE ROOM:
32. EMPLOYEE LOCKERS: (1) 48" W COAT LOCKER W/ PERFORATED DOORS, (6) 6 TIER BOX LOCKERS & (2) ADA LOCKERS W/ SAFETY VIEW DOORS
33. 5'-6"W X 2'-2"D EMPLOYEE COUNTER W/ (1) CABINET
34. EMPLOYEE ROOM REFRIGERATOR (PROVIDE 32" CLEARANCE WHEN NEXT TO COUNTER)
35. EMPLOYEE ROOM SINK (IN COUNTER)
36. 4'-6" MIRROR CENTERED ON WALL ABOVE COUNTER

MISCELLANEOUS:
37. "E" - ELECTRICAL OUTLET FOR FUTURE USE
38. VENDOR RACKS: REMOVE BASE DECK & SHOES; (END PANEL TO REMAIN)
39. PROVIDE OPENING FOR ONE-WAY GLASS (SEE INTERIOR ELEVATION FOR LOCATION)
40. NEWSPAPER RACK BY VENDOR
41. PICTURE CARE PLUS TERMINAL

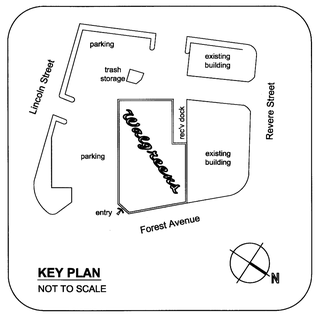

KEY PLAN
NOT TO SCALE

FOR REFERENCE ONLY: SEE CONTRACT DOCUMENTS FOR DETAILED SITE PLAN

TOTAL BY LINEAL FOOTAGE	1248 LN. FT.
FRONT WALL SHELVING (INCLUDE 54" HIGH WALL AT PHOTO)	39 LN. FT.
COSMETIC WALL SHELVING	93 LN. FT.
REMAINING WALL SHELVING (BACK & SIDE WALL, RX SEATING)	81 LN. FT.
BACK GONDOLAS	546 LN. FT.
FRONT GONDOLAS	264 LN. FT.
HALLMARK SHELVING	144 LN. FT.
COSMETIC GONDOLAS	48 LN. FT.
COOLERS	20 LN. FT.
FREEZERS	13 LN. FT.

* A.D.A DOOR CLEARANCES

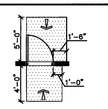

*ACCESSIBLE REQUIREMENTS MAY VARY WITH LOCAL JURISDICTIONS & APPROACH TO DOOR SWING

EXECUTIVE APPROVAL		DATE
SENIOR VICE PRESIDENT FACILITIES DEVELOPMENT		
SENIOR VICE PRESIDENT STORE OPERATIONS	Handal	01/1/08
VICE PRESIDENT STORE OPERATIONS	Arnoult Jr.	01/08/08
REVIEWED BY:	V.G.N. 12/10/07	D.B.A. 12/10/07

FIXTURE LEGEND

G GONDOLA (EA. SIDE)	18	18 D.	36 W.	66 * H.	ALL OTHER FIXTURES ARE TYPICALLY CALLED OUT DEPTH BY WIDTH. EXAMPLE:
GE GONDOLA END	18	D.	39 W.	66 * H.	
WS WALL SHLVG	18	D.	36 W.	84 * H.	DT 30 48
DISPLAY TABLE	D.	W.			

*DOES NOT INCLUDE STANDARDS, WOOD GROUNDS OR FINISHED END PANELS

Walgreens

FACILITIES PLANNING, DESIGN, & ENGINEERING
106 WILMOT ROAD
DEERFIELD, IL 60015-5105

PROJECT DATA

TYPE		GENERAL SALES	■	MARKET	■
NEW LOCATION	■	PHARMACY	■	SECURITY	3
NEW LOCATION EXIST'G BLDG	□	PHOTO	■	24 HOUR STORE	□
REMODEL	□	LIQUOR	□	OTHER	□

SQUARE FOOT AREA SUMMARY

DEPARTMENT		SALES	STOCK	SERVICE	TOTAL EXIST'G	TOTAL NEW
GEN SALES	NEW	8573	1698	1122		11,393
	EXIST'G					
MARKET	NEW	900				900
	EXIST'G					
RX	NEW	682				682
	EXIST'G					
RX WAIT'G	NEW	208				208
	EXIST'G					
PHOTO	NEW	435				435
	EXIST'G					
LIQUOR	NEW					
	EXIST'G					
BSMT	NEW					
	EXIST'G					
2ND FLOOR	NEW					
	EXIST'G					
TOTAL NEW		10,798	1698	1122		13,618
TOTAL EXST'G						

TOTAL AREA: FIRST FLOOR 13,618 SQ.FT.
TOTAL AREA: OTHER LEVELS 0 SQ.FT.
GROSS AREA INCLUDING ALL DEPARTMENTS & ALL LEVELS: 13,618 SQ.FT.
RX SHELVING LINEAL FEET: 85 LN.FT.

NO.	DATE	BY	DESCRIPTION	CONST

REVISIONS

CERTIFICATION AND SEAL

I HEREBY CERTIFY THAT THIS PLAN AND SPECIFICATION WAS PREPARED BY ME OR UNDER MY DIRECT SUPERVISION AND THAT I AM A DULY REGISTERED ARCHITECT OR ENGINEER UNDER THE LAWS OF THE STATE OF MAINE AS SIGNIFIED BY MY HAND AND SEAL.

STORE NUMBER 12325

PROJECT NAME
WALGREENS STORE
(SWC) FOREST AND REVERE
PORTLAND, MAINE

DRAWING TITLE
FIXTURE FLOOR PLAN

CADD PLOT: 12325-D1-06-17NOV08
VOID PLOT: 12325-D1-05-20AUG08
SUPERSEDES PLAN DATED:
SCALE: 1/8"=1'-0"
DRAWN BY: J. SUS
DATE: 12/04/07
REVIEWED BY: L. CUMMINGS 12/06/07
DRAWING NO. D1
OF DWGS.

JOSEPH SUS 11/17/2008 9:13 AM F:\JOBSJOES\12325-D1-06-17NOV08