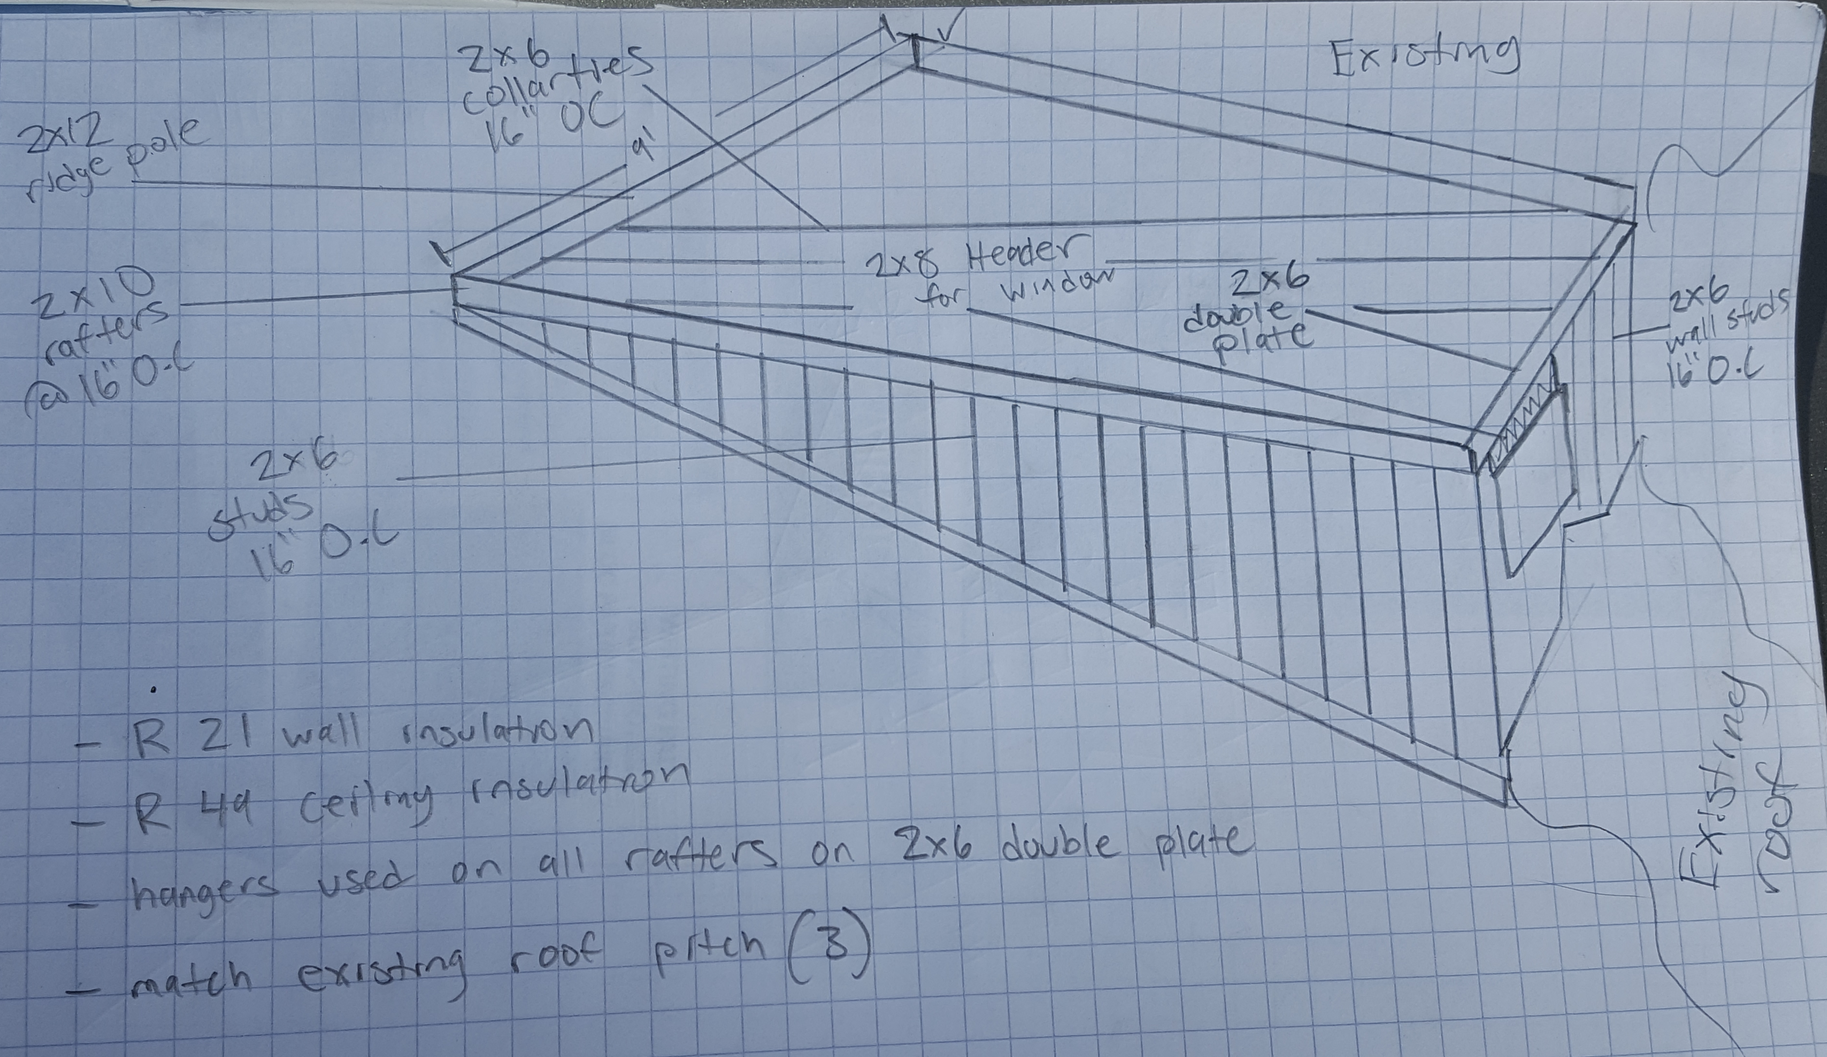

- R 21 wall insulation
- R 49 ceiling insulation
- hangers used on all rafters on 2x6 double plate
- match existing roof pitch (3)