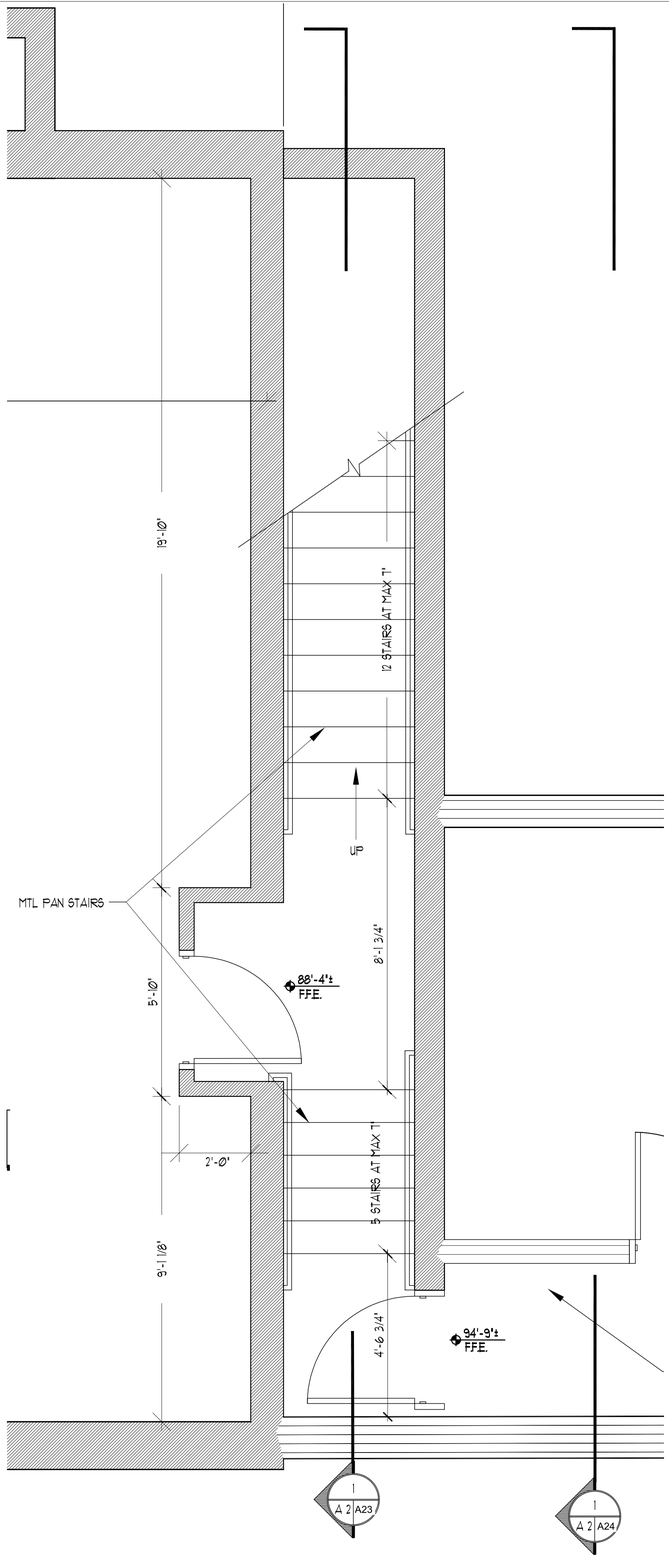

NOTE:
CONTRACTOR TO VERIFY DIMENSIONS & EXISTING CONDITION & REPORT TO ARCHITECT FOR COORDINATION PURPOSES

NOTE:
CONTRACTOR TO FIELD VERIFY ALL FLOOR TO FLOOR DIMENSIONS

NOTE:
HANDRAILS TO EXTEND 12" HORIZ. AT THE TOP OF ALL STAIR RUNS (MIN.) AND CONTINUE TO SLOPE AT THE BOTTOM OF ALL STAIR RUNS FOR A HORIZ. DISTANCE OF 11" (MIN.) TYP.

2 LOWER LEVEL STAIR PLAN

Ø 2'-Ø" SCALE: 1/2" = 1'-Ø"

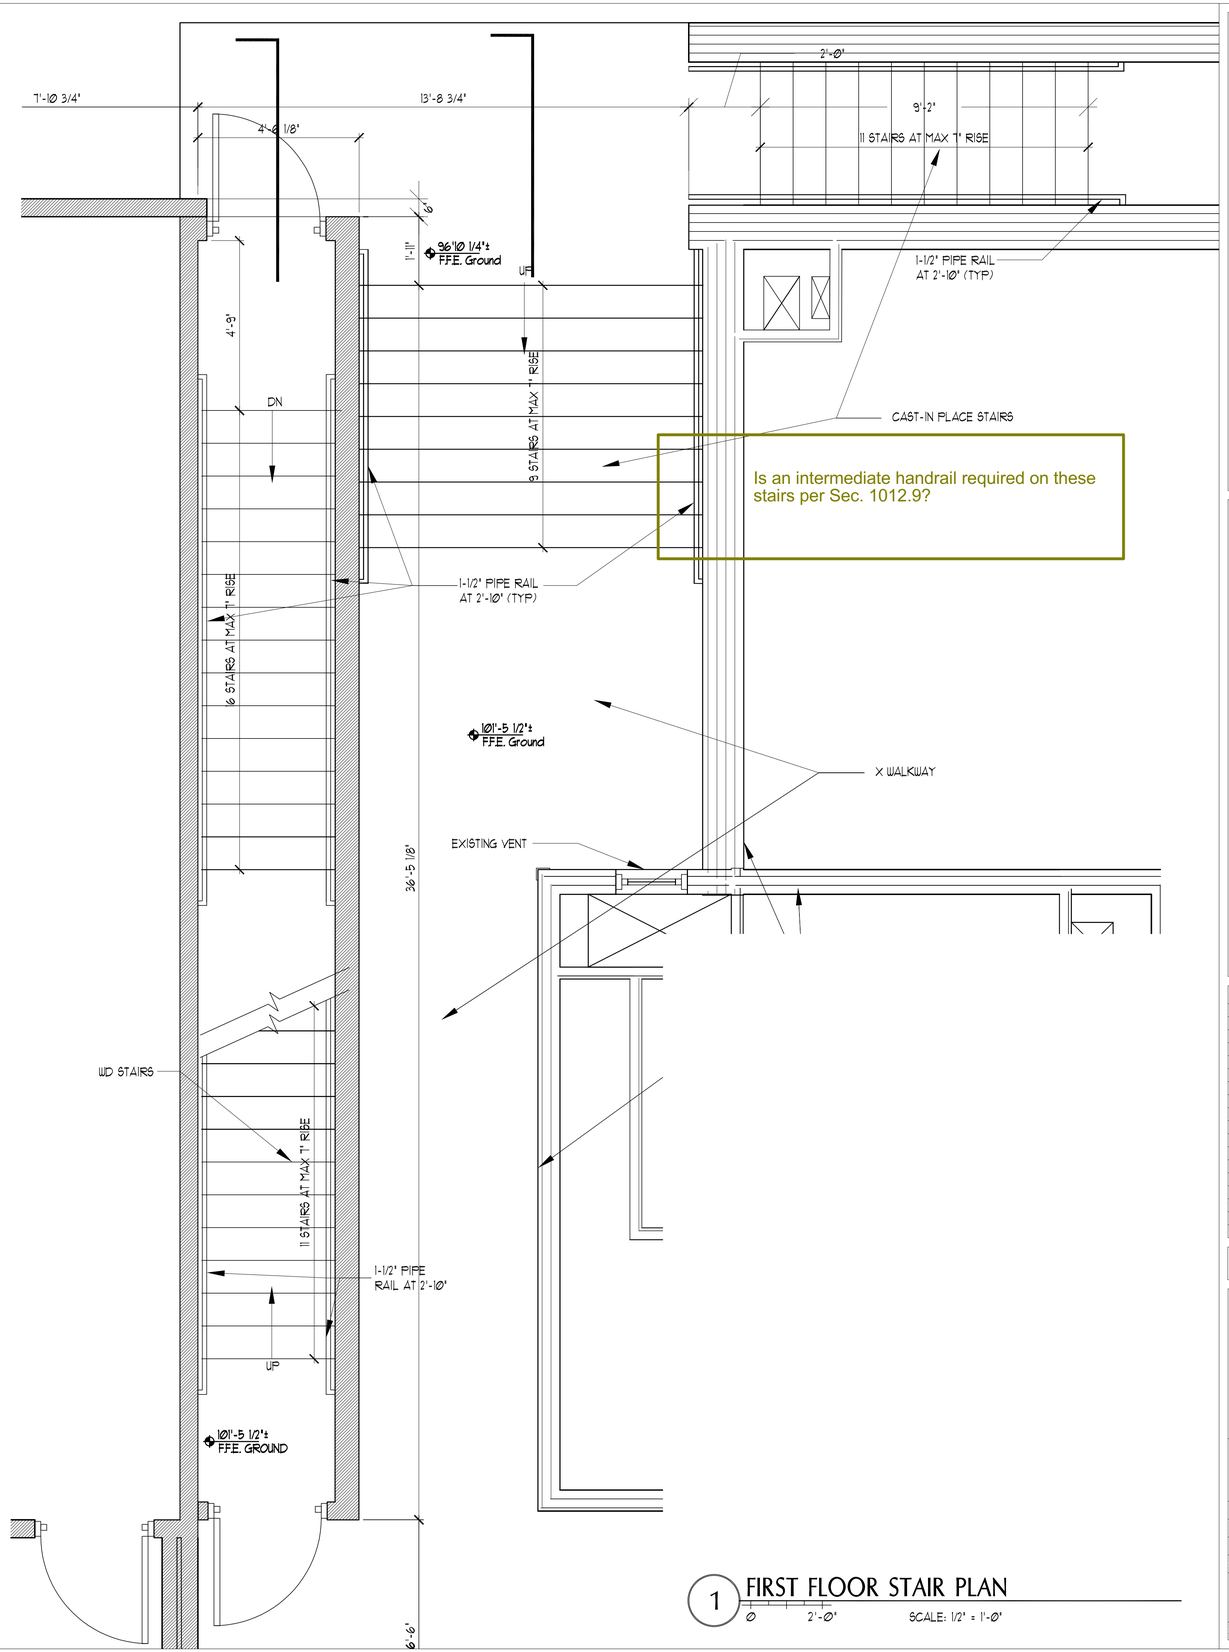

1 FIRST FLOOR STAIR PLAN

Ø 2'-Ø" SCALE: 1/2" = 1'-Ø"

65 NEWBURY STREET
PORTLAND, ME 04101
207.761.9000
info@portcityarch.com
WWW.PORTCITYARCH.COM

REGISTERED ARCHITECT
LITA SEMERU
NO. 2657
MAINE

UNE
UNIVERSITY OF NEW ENGLAND
Allied Engineering
Structural Mechanical Electrical Commissioning
CONSIGLI
Est. 1905
BECKER
STRUCTURAL ENGINEERS

PERMIT SET

REVISIONS

No.	Description	Date
-	-	-

UNIVERSITY OF NEW ENGLAND
PORTLAND, MAINE

ALUMNI HALL RENOVATION

ABPLANALP STAIR PLAN

Project Number	14525
Date	May 01, 2015
Drawn by	JP TS SM AR
Checked by	LAS

A31

Scale AS NOTED