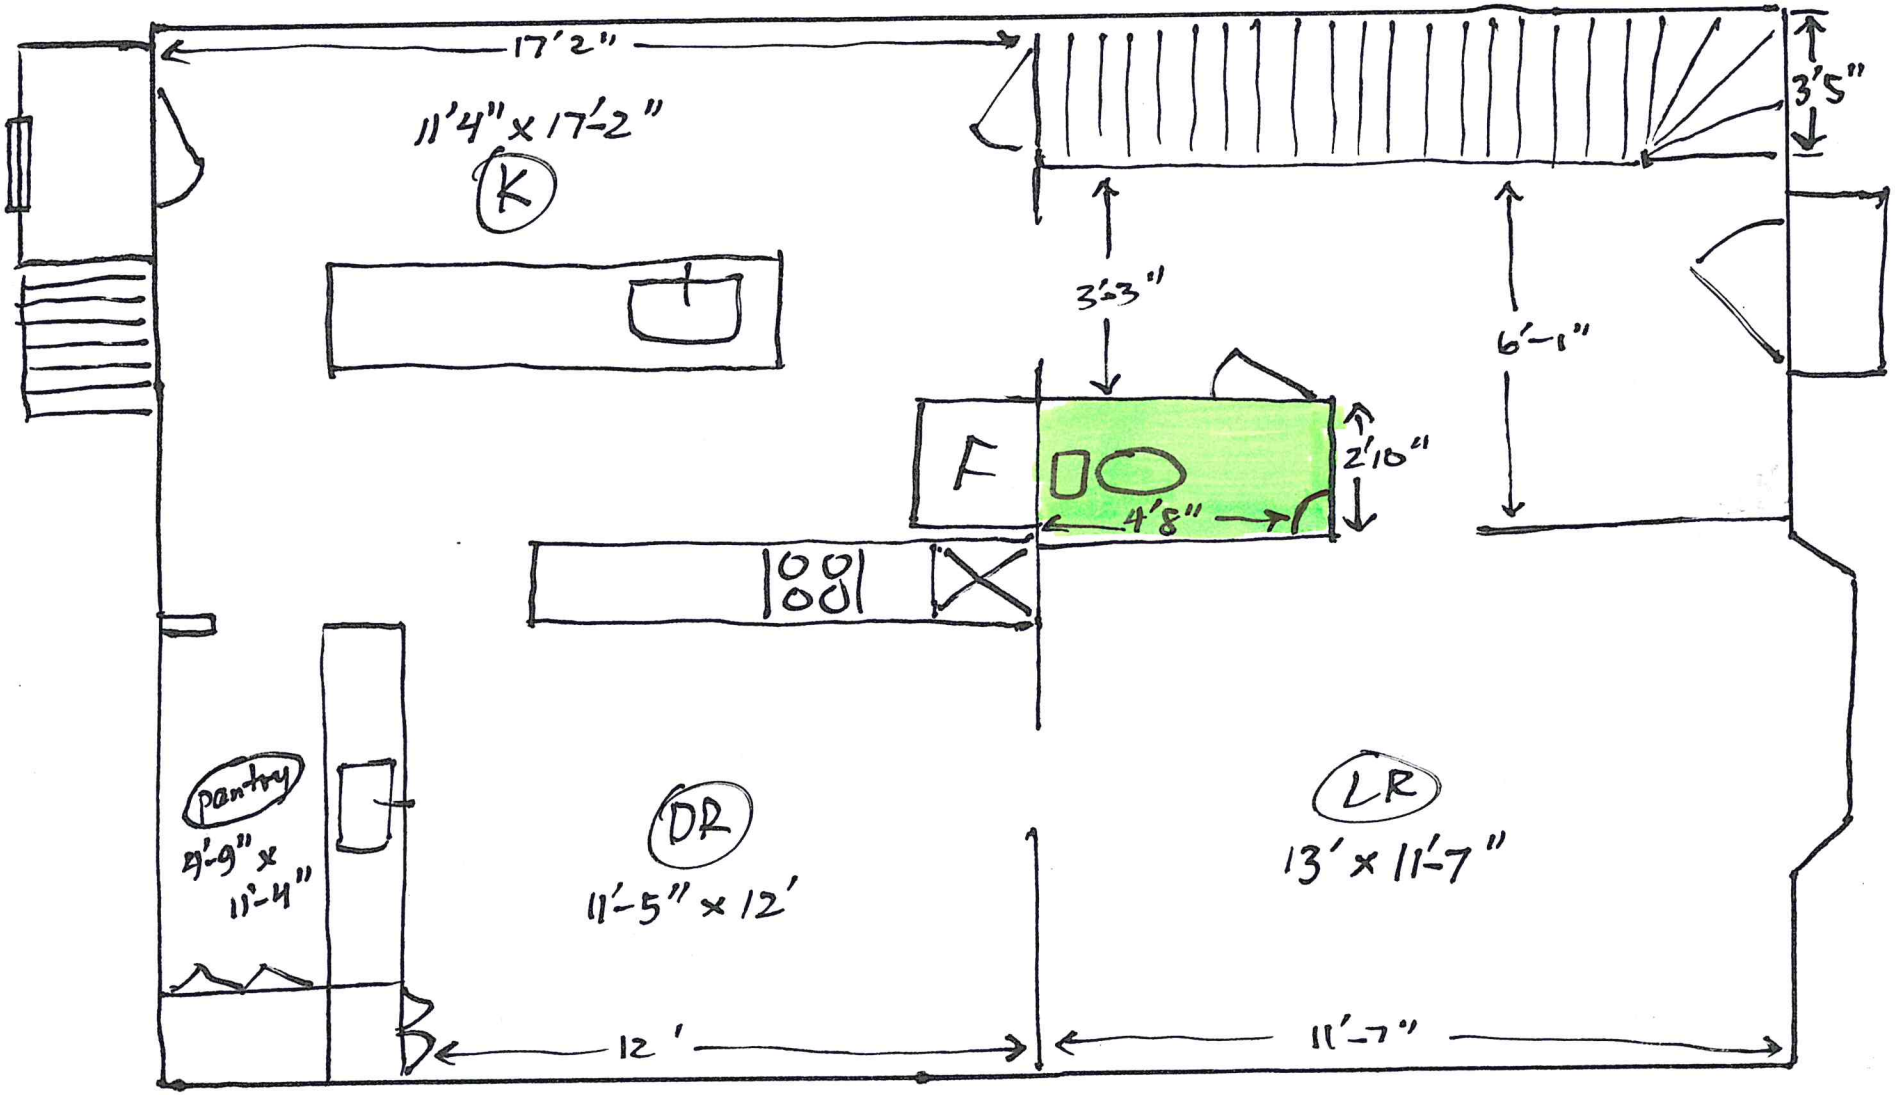

SCALE: N.T.S.	APPROVED BY:	DRAWN BY
DATE: 11/2015		REVISED
PLUMMER / RANDALL STREET / Floorplan 1st Floor		
BATHROOM Install IN EXISTING SPACE NO STRUCTURAL CHANGE		DRAWING NUMBER 3

* Converted closet to 1/2 BATH NOTED IN GREEN