


LANDSCAPING &  
LIGHTING

Designed TNE	Date 12-23-04
Drawn TNE	Scale 1" = 20'
Checked DAK	RESUME FOR PRELIMINARY BID
Revision	RESUME FOR PRELIMINARY BID
	FINAL SITE PLAN REVIEW
	GENERAL REVISIONS
	PERMIT SUBMISSION
	11-22-06

THE INN AT CEDARS  
630 OCEAN AVENUE, PORTLAND, MAINE  
PREPARED FOR:  
JHA SERVICES, INC.  
630 OCEAN AVENUE  
PORTLAND, MAINE

Land Use Consultants, Inc.  
1000  
Voice 207 878-2313  
Fax 207 878-2313  
966 RIVERSIDE STREET  
PORTLAND, MAINE 04103

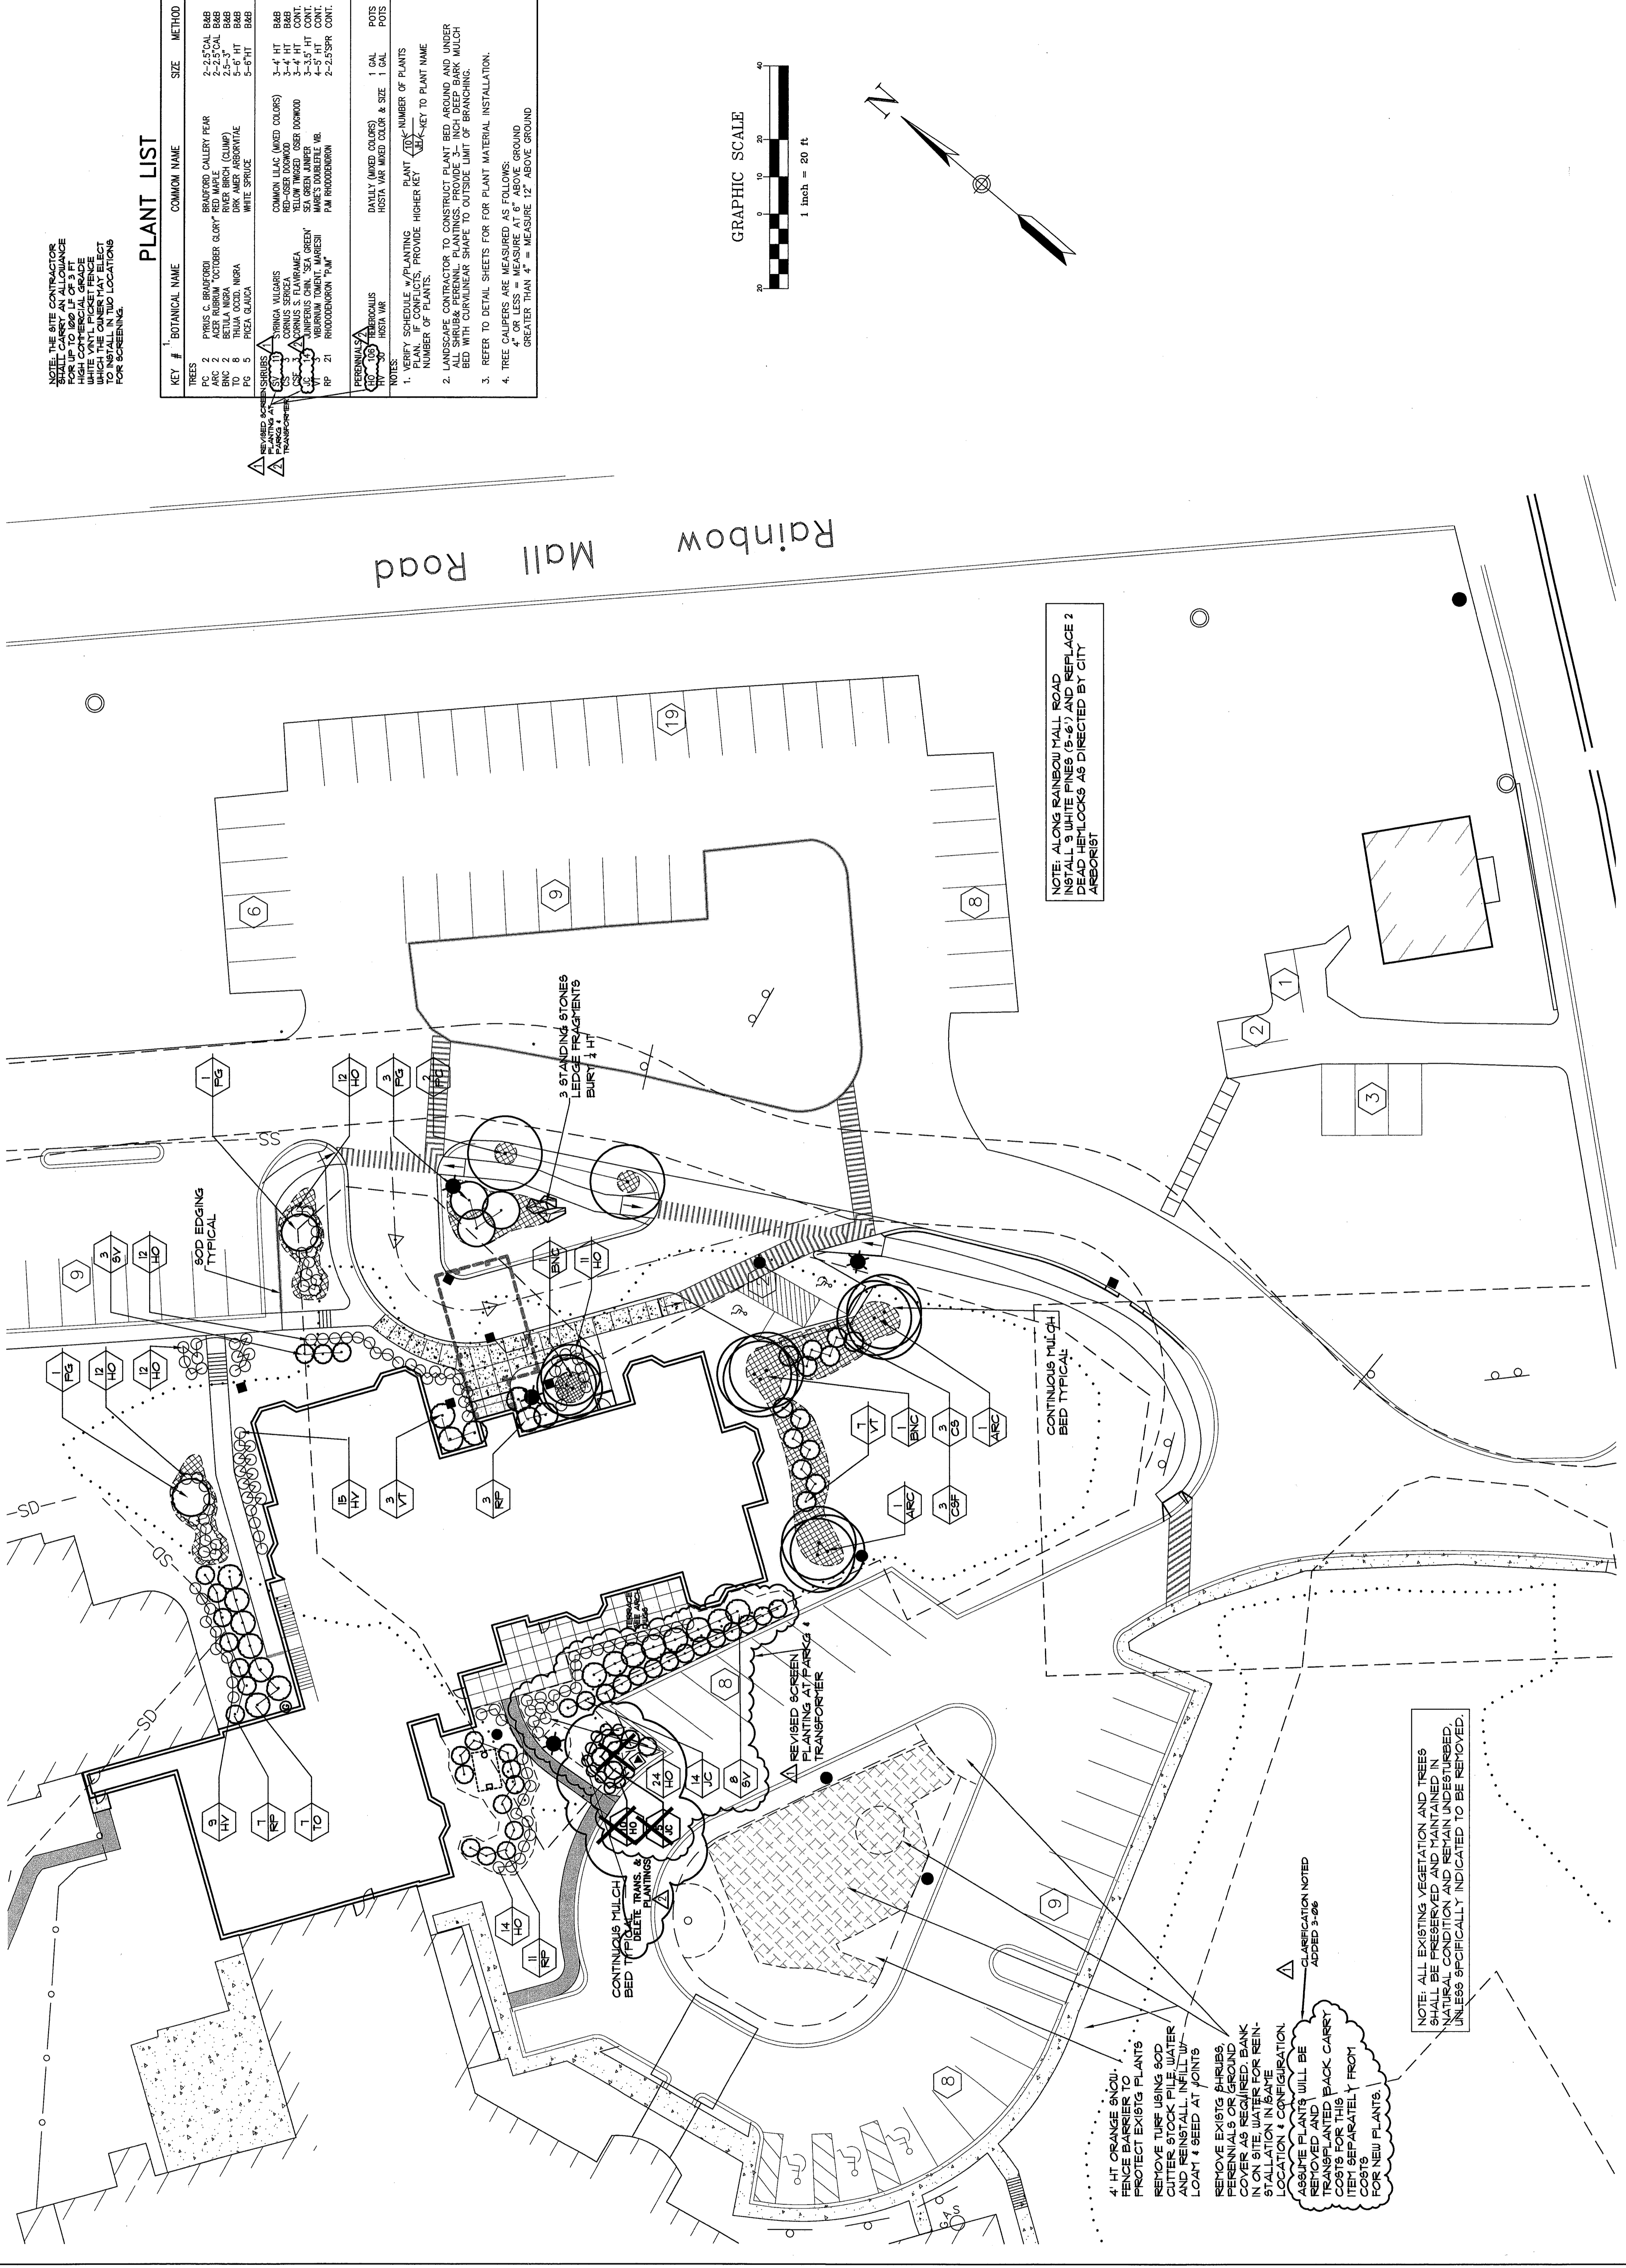

**PLANT LIST**

KEY #	BOTANICAL NAME	COMMON NAME	SIZE	METHOD
1	PRUNUS C. BRAYFORD	BRAYFORD GALLERY PEAR	2-2.5 CAL	B&B

1. VERIFY SCHEDULE #/PLANTING PLANT #/NUMBER OF PLANTS PLANT #/KEY TO PLANT NAME  
2. LANDSCAPE CONTRACTOR TO CONSTRUCT PLANT BED AROUND AND UNDER ALL SHRUBS PERMANENT PLANTINGS. PROVIDE 3" RICH DEEP BARK MULCH BED WITH CONTOURING SHAPE TO OUTSIDE LIMIT OF BRANCHING.  
3. REFER TO DETAIL SHEETS FOR PLANT MATERIAL INSTALLATION.  
4. TREE CALIPERS ARE MEASURED AS FOLLOWS:  
A. MEASURE 4" ABOVE GROUND  
B. MEASURE 12" ABOVE GROUND  
C. MEASURE 4" ABOVE GROUND

