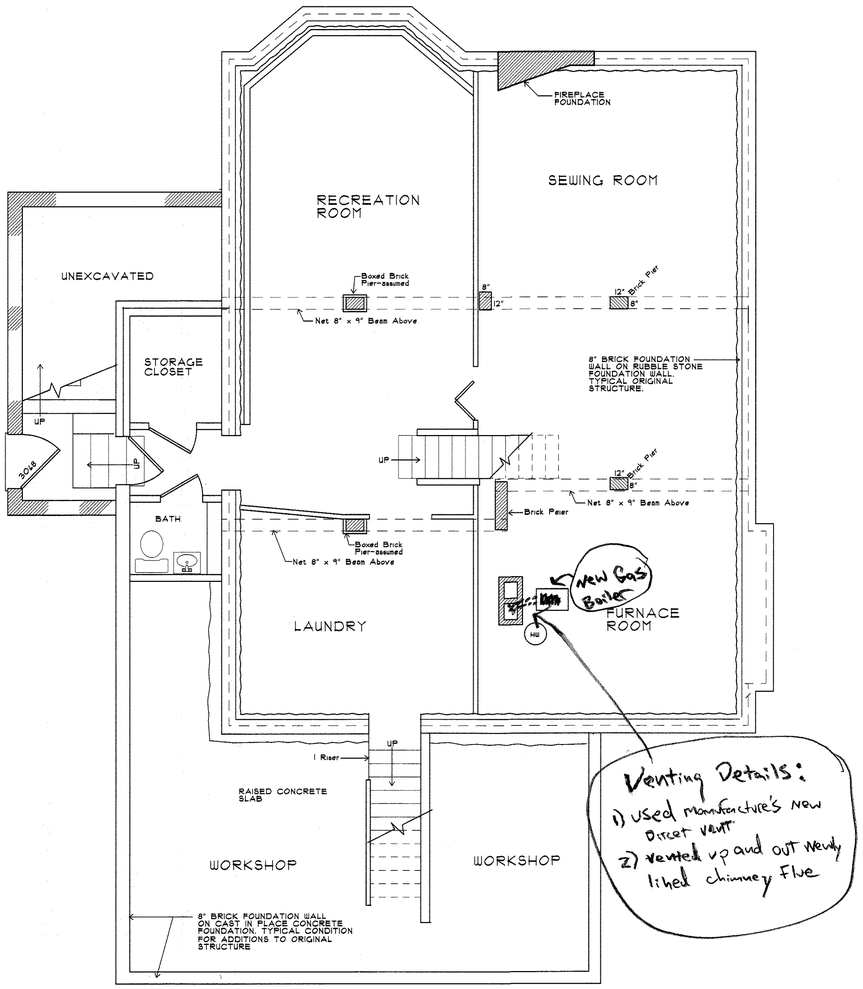

BASEMENT FLOOR PLAN
AS-BUILT 1/4" = 1'-0"

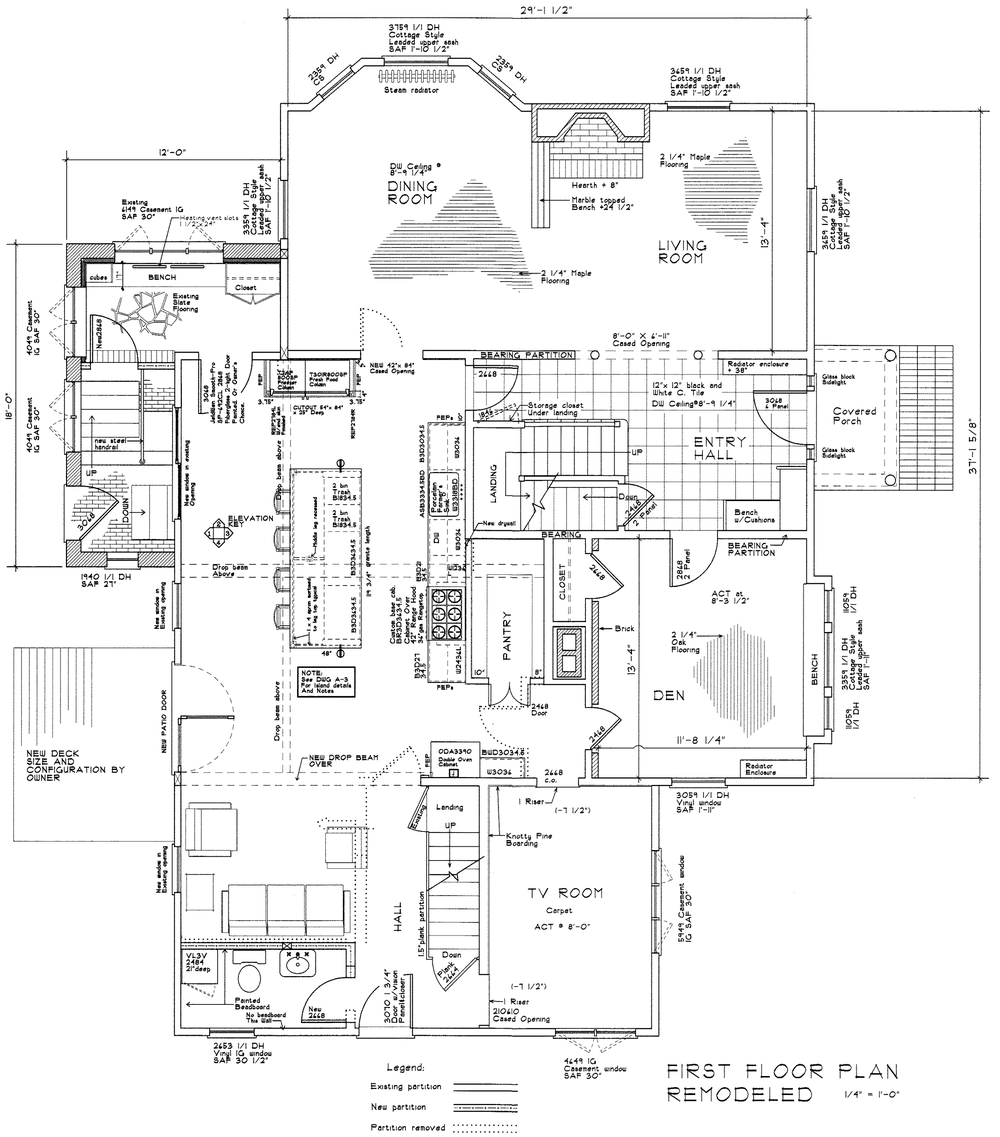
29'-1 1/2"
12'-0"
18'-0"
37'-1 5/8"
3759 1/1 DH Cottage Style Leaded upper sash SAF 1'-10 1/2"
2359 DH CW
2359 DH CW
3659 1/1 DH Cottage Style Leaded upper sash SAF 1'-10 1/2"
Steam radiator
DW Ceiling @ 8'-9 1/4"
DINING ROOM
Hearth + 8"
Marble topped Bench +24 1/2"
2 1/4" Maple Flooring
LIVING ROOM
13'-4"
3659 1/1 DH Cottage Style Leaded upper sash SAF 1'-10 1/2"
Existing 4149 Casement IG SAF 30"
Existing 3351 1/1 DH Cottage Style Leaded upper sash SAF 1'-10 1/2"
Heating vent slots 1 1/2" x 24"
cubes
BENCH
Closet
Existing Slate Flooring
4049 Casement IG SAF 30"
4049 Casement IG SAF 30"
Wet Area
new steel handrail
UP
DOWN
3068
FEP
3.75"
7.50"
7.50"
3.75"
NEW 42"x 84" Cased Opening
8'-0" X 6'-11" Cased Opening
BEARING PARTITION
2448
Storage closet under landing
12"x 12" black and White C. Tile
DW Ceiling@8'-9 1/4"
Radiator enclosure + 38"
Glass block Sidelight
Covered Porch
Glass block Sidelight
3068 2 Panel
ENTRY HALL
LANDING
UP
Door
2468 2 Panel
Bench w/Cushions
BEARING
BEARING PARTITION
New drywall
1940 1/1 DH SAF 21"
ELEVATION KEY
Drop beam Above
