15 Jeanne Court

A correction of dimension to on left side foundation of addition.

Left side dimension was originally listed as 9' from back of existing house to rear wall of new foundation.

Correct dimension should be 11'.

Reason for incorrect dimension.

1) Though the overall dimension for the garage are correct 27'-6 by 26'-0" the rear wall measuring 38'-6". However the rear wall as drawn is 11" off. So when scaled the dimension of the garage actually measure at 25'-2".
2) The existing house foundation as draw is 24'-0" The actual foundation of existing home is 22'-11"

The error in scale of 10"and the error in existing foundation of 13" is what accounts for the dimension error.

BECAUSE ALL SETBACKS WHERE LAYED OUT FROM THE CORRECT LOCATION OF THE FRONT WALL OF THE ADDITION WHERE IT MEETS THE EXISTING FOUNDATION ALL SETBACK ARE CORRECT.
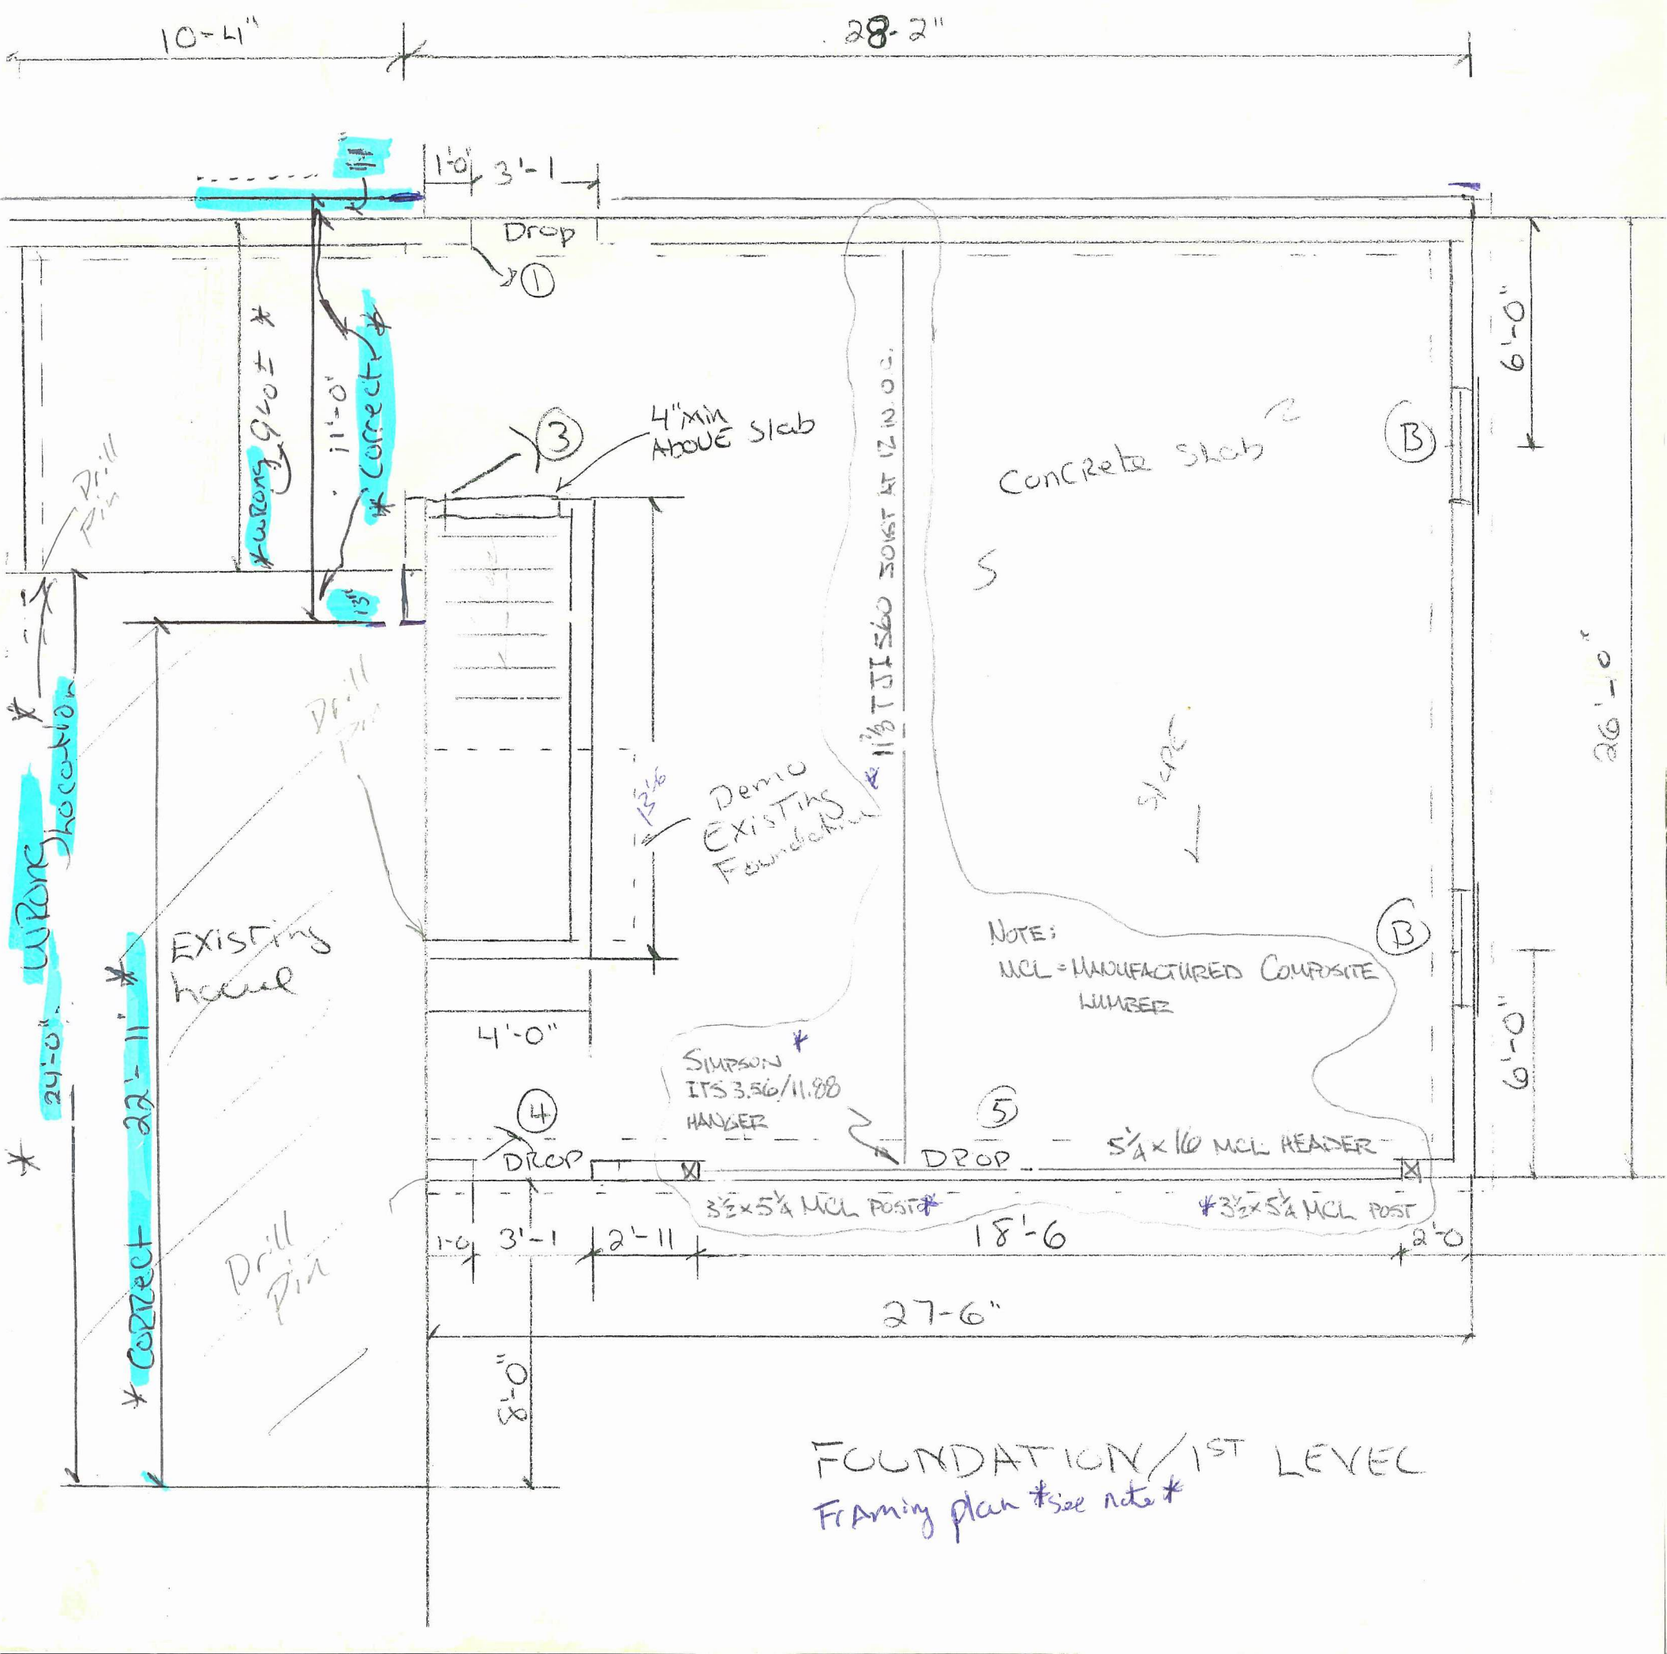
Richard Ledue: 653-0807