Reviewed for Code Compliance
Please Note Changes
Date: 11/22/16

NSF

BALLY FLOOR PANEL GUIDELINES

OVERALL FLOOR SIZE MUST BE 4" SMALLER THAN COOLER OR FREEZER INSIDE DIMENSIONS.


MAXIMUM FLOOR SIZE IS 10' FT. LENGTHWAY DISTRIBUTED.

MOBILE EQUIPMENT (DOLLIES OR CARTES): MUST HAVE POLYURETHANE WHEELS. METAL WHEELS SHOULD NOT BE USED ON FLOOR PANELS. RUBBER MATTING OR ALUMINUM DIAMOND TREAD OVERLAY IS ALSO AN OPTIONS.

CONCRETE SLOPE: MINIMUM 1/4" PER FOOT. SLOPED CONCRETE MUST BE POURED OVER BALLY FLOOR PANELS.

AIR GAP/CIRCULATION RECOMMENDATION - BALLY RECOMMENDS A 2" GAP BETWEEN WALL-IN COOLER/FREEZER AND WALL OR CEILING. IF NOT PROVIDED AN AIR CIRCULATION KIT IS ALSO RECOMMENDED THAT WILL EXCHANGE/CIRCULATE AIR PROVIDED FOR WALK-INS THAT ARE WITHIN AN ENCLOSED AREA.


S - ELECTRICAL CONNECTION

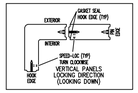


THIS DRAWING IS TO BE USED FOR "APPROVAL ONLY".

-> DO NOT USE THIS DRAWING FOR INSTALLATION!

EVERY SHIPPED ORDER WILL HAVE A FINALIZED "AS-BUILT" DRAWING.

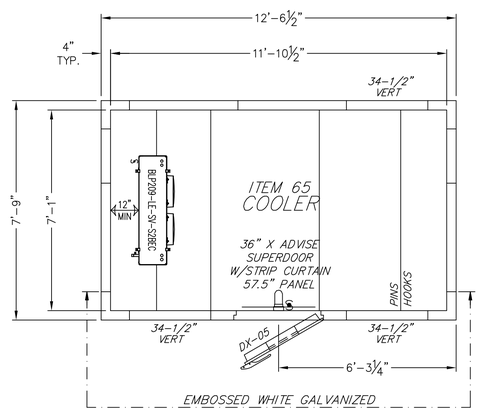

— PLAN VIEW B —

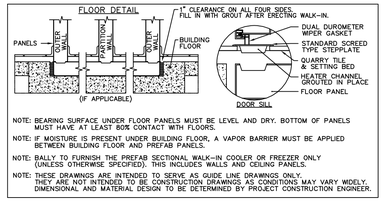

NOTE: BEARING SURFACE UNDER FLOOR PANELS MUST BE LEVEL AND DRY. BOTTOM OF PANELS MUST HAVE AT LEAST 80% CONTACT WITH FLOORS.

NOTE: IF MOISTURE IS PRESENT UNDER BUILDING FLOOR, A VAPOR BARRIER MUST BE APPLIED BETWEEN BUILDING FLOOR AND PREFAB PANELS.

NOTE: BALLY TO FURNISH THE PREFAB SECTIONAL WALK-IN COOLER OR FREEZER ONLY (UNLESS OTHERWISE SPECIFIED). THIS INCLUDES WALLS AND CEILING PANELS.

NOTE: THESE DRAWINGS ARE INTENDED TO SERVE AS GUIDE LINE DRAWINGS ONLY. THEY ARE NOT INTENDED TO BE CONSTRUCTION DRAWINGS AS CONDITIONS MAY VARY WIDELY. DIMENSIONAL AND MATERIAL DESIGN TO BE DETERMINED BY PROJECT CONSTRUCTION ENGINEER.

GENERAL NOTES

- NOTE: BALLY TO FURNISH (4) K1810 48" LED LIGHTS. LIGHTS SHIPPED LOOSE AND MOUNTED AND WIRED BY OTHERS. (LIGHT SWITCH (12) AMPS MAX).
- NOTE: BALLY TO FURNISH EW CLOSURE TRIM. PLEASE ADVISE SIZE AND QUANTITY. ALL FASTENERS AND INSTALLATION BY OTHERS.

TILE THICKNESS

TO STOP TILE CRACKS OVER BALLY FLOORS, BALLY RECOMMENDS MINIMUM 2" TILE AND SETTING BED.

SPECIFICATIONS

12'-6 1/2" X 7'-9" X 8'-6"

INSTALLATION
- INDOOR
- LOADING HEIGHT - AT LEAST 18" OF OPEN SPACE MUST BE MAINTAINED BETWEEN TOP OF PRODUCT AND CEILING PANELS

INSULATION
- FOAMED IN-PLACE POURED URETHANE

EXTERIOR FINISH
- EMBOSSED WHITE GALVANIZED AS SHOWN
- EMBOSSED WHITE GALVANIZED CEILING
- EMBOSSED GALVALUME REMAINDER

INTERIOR FINISH
- EMBOSSED WHITE GALVANIZED

FLOOR FINISH
- (INTERIOR) 16GA. GALVANIZED STEEL
- (EXTERIOR) EMBOSSED GALVALUME


DOORS/ACCESSORIES
- (1) 36" X ADVISE RIGHT SWING HINGED WALK-IN DOOR
  - SUPERDOOR: 3RD HINGE, DT INT & EXT 36"H
  - STRIP CURTAIN
  - VAPOR-PROOF LIGHT W/ LED BULB
  - MODULARM 75LC W/ MAG CONTACTS, PANIC BUTTON, MOTION DETECTOR
  - 14" x 24" HEATED OBSERVATION WINDOW
  - EXTERIOR CROSSOVER CORD

REFRIGERATION - BY BALLY (CONDENSING UNIT MOUNTED OUTDOORS)

1 0.8 R404A BEWD08-E8-HS2BB 208-230/1/60 5.4 40.0 1 0.5 7.3 15 C

- (1) HEATED & INSULATED RECEIVER FOR CONDENSING UNIT
- (1) WINDGUARD FOR CONDENSING UNIT

NOTE

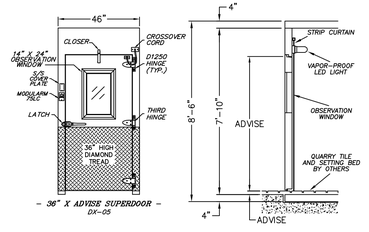

— SECTION VIEW —
THRU ENTRANCE DOOR

SHEET 2 OF 2

RESTRICTED, CONFIDENTIAL DOCUMENT.

THIS DRAWING AND ALL INFORMATION SHOWN HEREON ARE THE EXCLUSIVE PROPERTY OF BALLY REFRIGERATED BOXES INC. ARE SUBMITTED ONLY ON A CONFIDENTIAL BASIS. THE RECIPIENT AGREES NOT TO REPRODUCE THE DRAWING, TO RETURN IT UPON REQUEST, AND THAT NO DISCLOSURE OF THE DRAWING OR THE INFORMATION SHOWN HEREON WILL BE MADE TO A THIRD PARTY WITHOUT PRIOR WRITTEN CONSENT FROM BALLY REFRIGERATED BOXES INC.

SIGNED APPROVAL

SIGNED _____

DATE _____

PLEASE READ

THIS DRAWING HAS BEEN CAREFULLY CHECKED BY OUR DRAFTING DEPARTMENT. HOWEVER, ERRORS OF INTERPRETATION CAN OCCUR. THEREFORE, BEFORE YOU RETURN DRAWING MARKED "APPROVED", BE CERTAIN THAT YOU CHECK THEM CAREFULLY.

NOTE - THIS ORDER WILL NOT BE SCHEDULED FOR PRODUCTION UNTIL RECEIPT OF APPROVED DRAWINGS BY BALLY.

IMPORTANT - PLEASE READ

THESE DRAWINGS ARE NOT TO BE CONSIDERED AS APPROVED BY LOCAL OR STATE BUILDING AUTHORITIES.

THEY HAVE BEEN PREPARED SOLELY FOR THE GUIDANCE OF REGISTERED ARCHITECTS AND ENGINEERS AND FOR THE ASSISTANCE OF LOCAL INSTALLERS. IT IS THE RESPONSIBILITY OF THE PROJECT ARCHITECT OR ENGINEER TO ASSURE THE BUILDING DESIGN MEETS LOCAL CODE REQUIREMENTS. THIS INCLUDES STRUCTURAL DESIGN AS WELL AS ANY WORK PERFORMED BY THE GENERAL CONTRACTOR, LOCAL INSTALLERS OR OTHER TRADES. BALLY REFRIGERATED BOXES INC., IN PREPARING THESE SPECIFICATIONS, DOES NOT ASSUME ANY RESPONSIBILITY FOR THE SUCCESSFUL COMPLETION OR USAGE OF THE STRUCTURE DESCRIBED.

THE DRAWINGS AND SPECIFICATIONS DESCRIBE A BUILDING ASSEMBLED FROM BALLY PANELS INSULATED WITH URETHANE "FOAMED-IN-PLACE". THE SIZE AND SHAPE IS THAT WHICH MOST CLEARLY MEETS DIMENSIONS SUBMITTED BY THE USER.

BALLY REFRIGERATED BOXES INC., PROVIDES PANELS FREQUENTLY SPECIFIED BY OTHERS, AND IS NOT RESPONSIBLE FOR THE SELECTION OR RECOMMENDATION BY OTHERS OF THE PANEL FINISH FOR ANY BUILDING OR WALK-IN APPLICATION.

REV	DESCRIPTION	BY	DATE

Bally REFRIGERATED BOXES INC.

BALLY INC OFFICE
1325 BOYER ROAD SUITE
MORGAN CITY, NC 28557
PHONE: (252) 340-2650
FAX: (252) 340-1084

BALLY PA OFFICE
1150 BERLIN PIKE, STE. (SUITE 8)
BALLY PA 19503
PHONE: (610) 702-2250
FAX: (610) 702-2211

FOR THOMPSON POINT

DRAWING NUMBER	5071916BC	DATE	07/25/16
DRAWN BY	RCB	ORDER NUMBER	5071916
LEAD BY	DATE LEAD	CHK'D BY	

C:\Users\Thomas\Documents\TJM Logo's\TJM_Small_Logo.jpg

TJM CONSULTING, INC.
273 MAIN STREET, SUITE 5
YARMOUTH, MAINE 04096
PHONE: (207) 215-4736
E-MAIL: TOM@TJMCONSULTING.NETnet

THOMPSON POINT - BRICK SOUTH
CATERING KITCHEN

THIS DRAWING AND ALL INFORMATION HEREIN ARE THE PROPERTY OF THE DESIGNER AND MAY NOT BE USED OR COPIED, EITHER IN WHOLE OR IN PART, WITHOUT THE EXPRESSED WRITTEN CONSENT OF THE DESIGNER

REV NO:	REVISIONS:

PROJECT: BRICK SOUTH KITCHEN
DATE:
DRAWN BY: T. MCARDLE
CHECKED BY: T. MCARDLE
SHEET TITLE: FOODSERVICE EQUIPMENT WALK-IN BEER COOLER DETAIL
SHEET NO: FS-11
SCALE: NONE