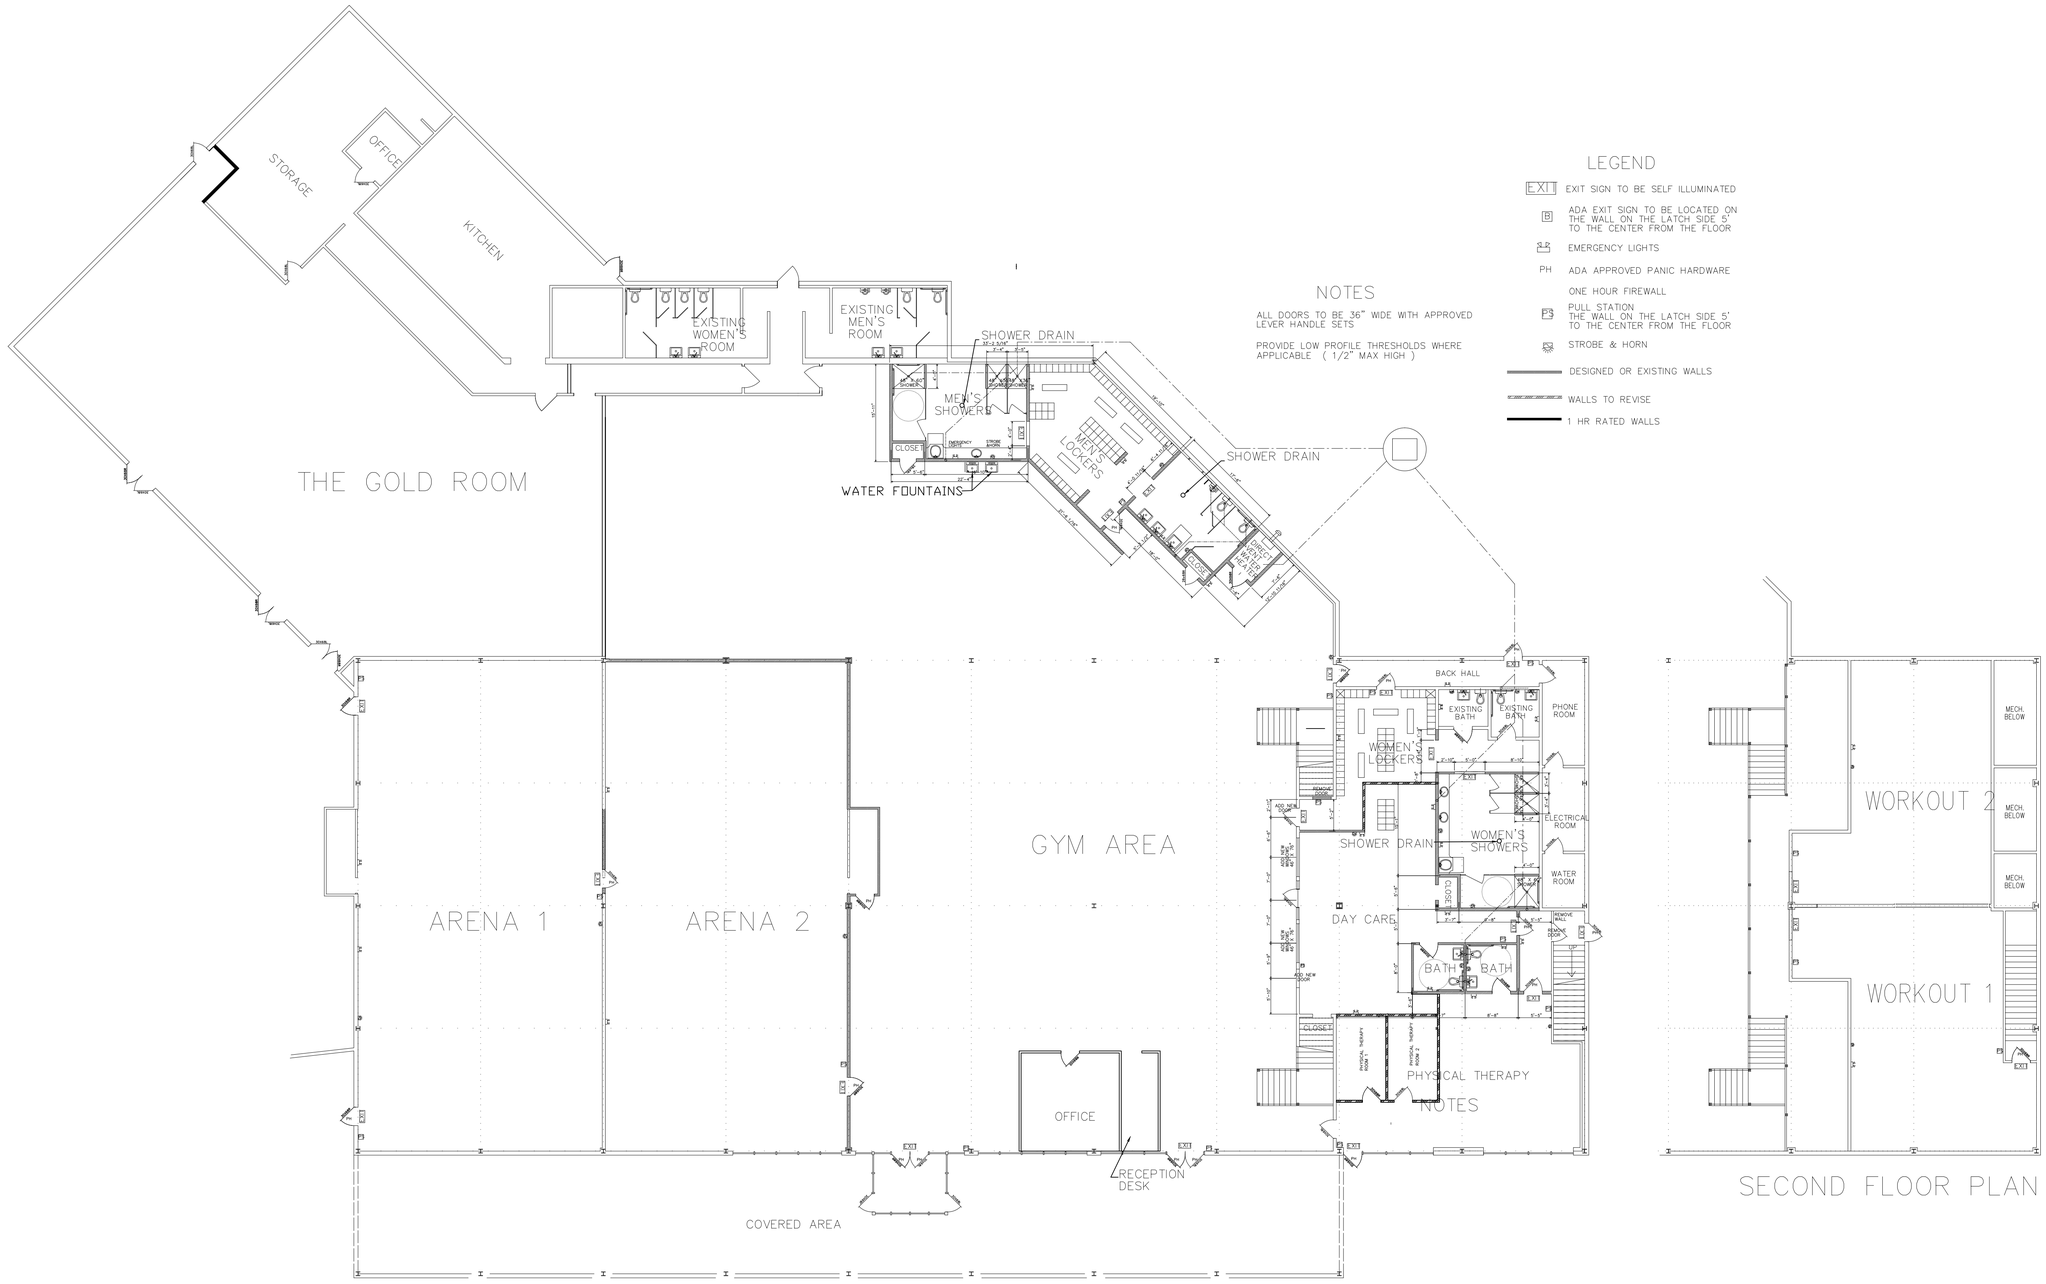

FIRST FLOOR PLAN

SECOND FLOOR PLAN

NOTES

ALL DOORS TO BE 36" WIDE WITH APPROVED LEVER HANDLE SETS

PROVIDE LOW PROFILE THRESHOLDS WHERE APPLICABLE (1/2" MAX HIGH)

LEGEND

- EXIT — EXIT SIGN TO BE SELF ILLUMINATED
- B — ADA EXIT SIGN TO BE LOCATED ON THE WALL ON THE LATCH SIDE 5' TO THE CENTER FROM THE FLOOR
- EMERGENCY LIGHTS
- PH — ADA APPROVED PANIC HARDWARE
- ONE HOUR FIREWALL
- PS — PULL STATION THE WALL ON THE LATCH SIDE 5' TO THE CENTER FROM THE FLOOR
- STROBE & HORN
- DESIGNED OR EXISTING WALLS
- WALLS TO REVISE
- 1 HR RATED WALLS

GRAPHIC SCALE

50 0 50 100 150 (FEET)

NO.	DESCRIPTION	DATE
	REVISIONS	

FLOOR PLAN
PORTLAND SPORTS CENTER
WARREN AVENUE PORTLAND, MAINE

FOR: JIM GRATTELO
PORTLAND SPORTS REALTY, LLC
550 WARREN AVE
PORTLAND, MAINE 04103

ATTAR ENGINEERING, INC.
CIVIL ◆ STRUCTURAL MARINE
1284 STATE ROAD – ELIOT, MAINE 03903
PHONE: (207)439–6023 FAX: (207)439–2128

SCALE: –	APPROVED BY:	DRAWN BY:
DATE: 9/23/14		REVISION : DATE
JOB NO: C068–14	CAD FILE: DOME_CEILING	SHEET 1