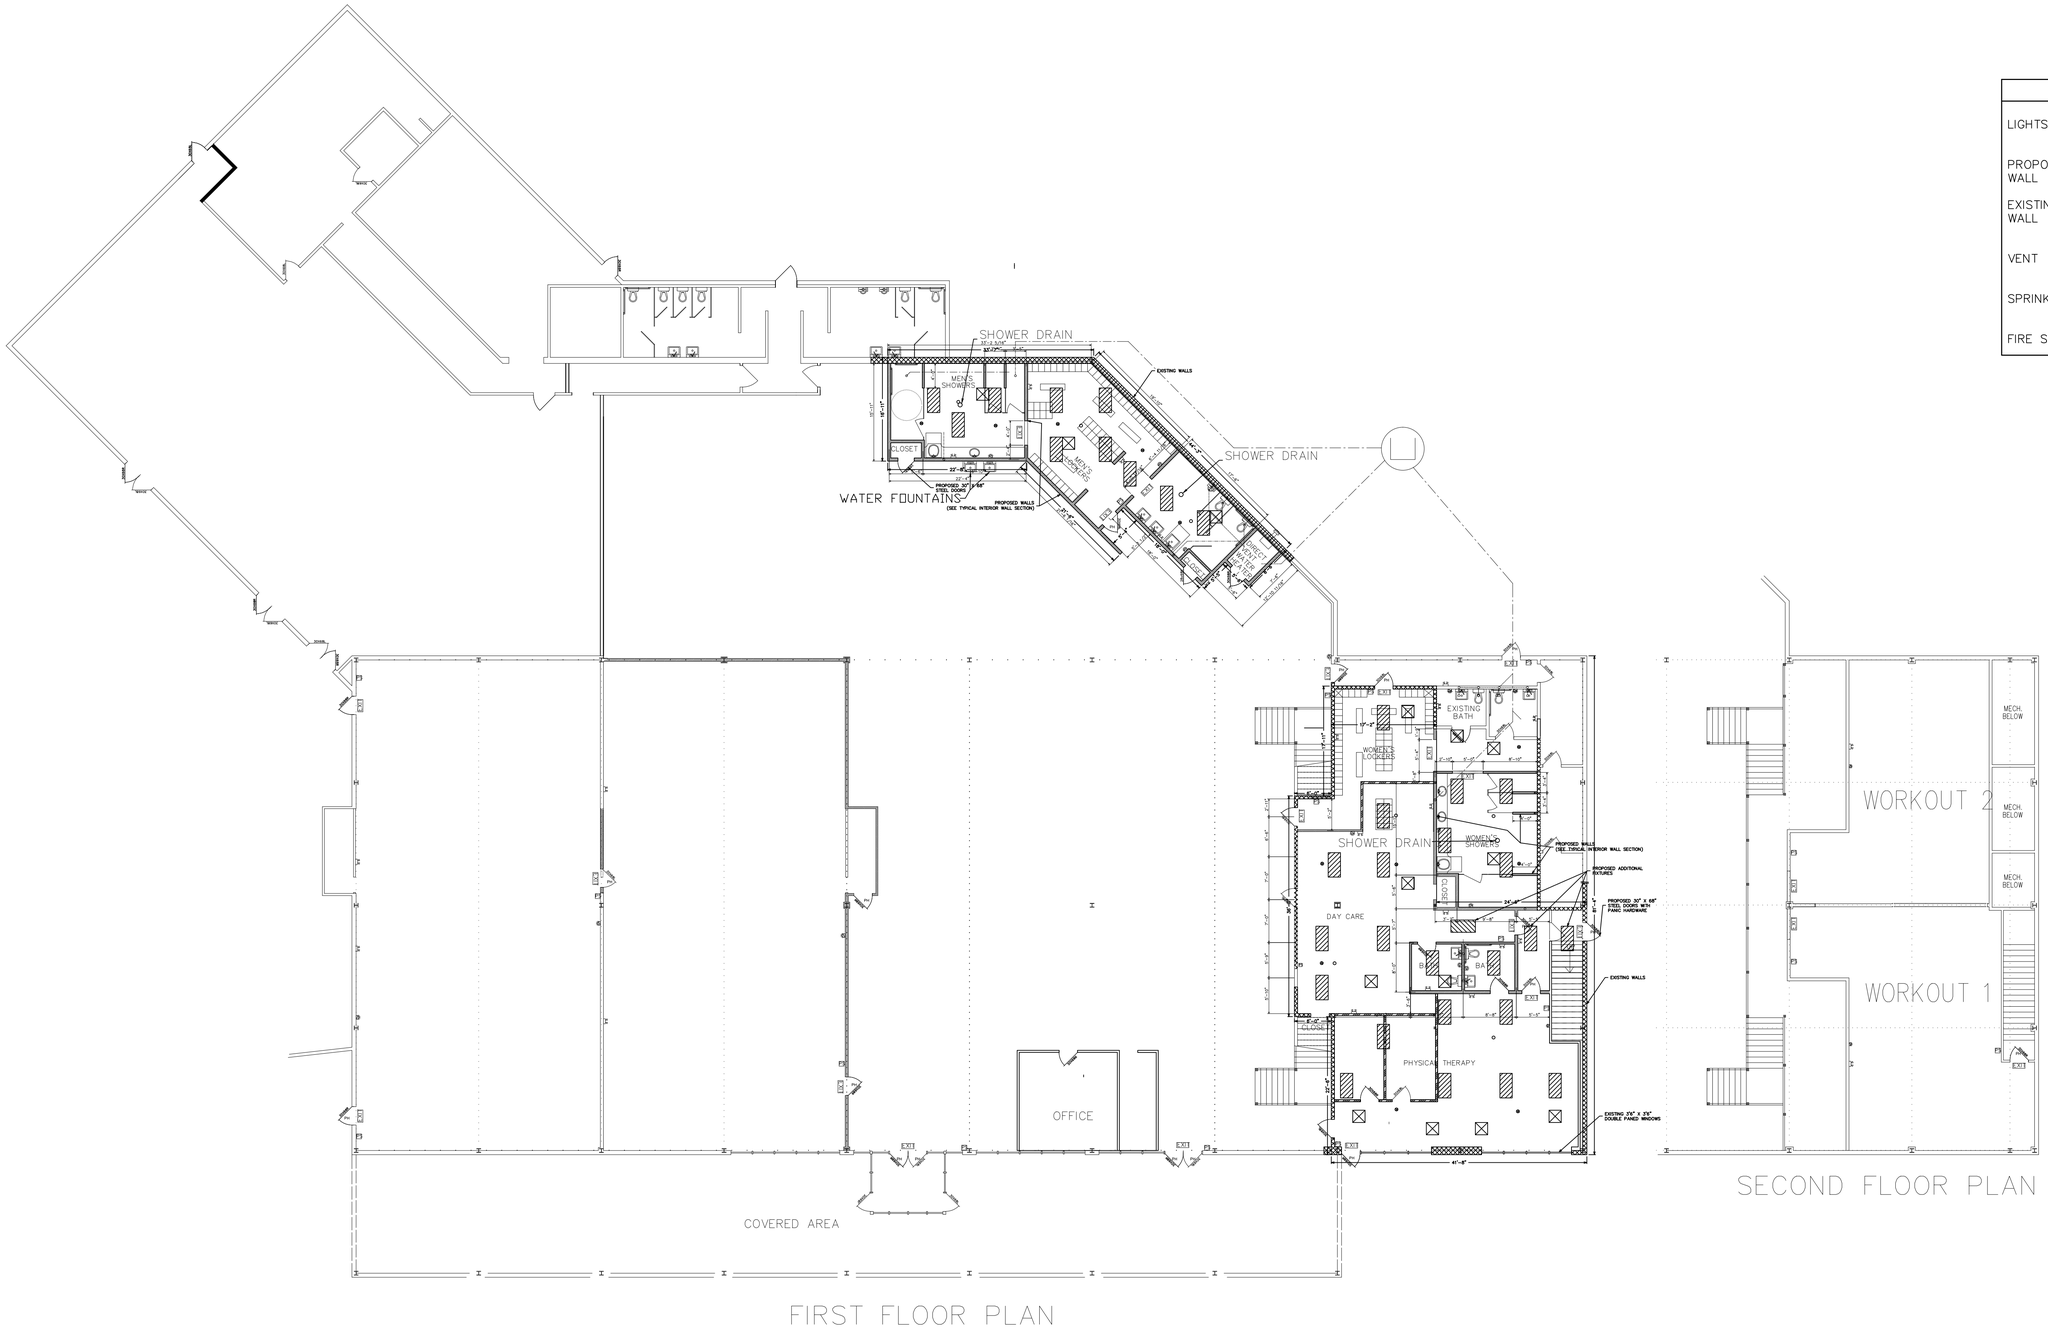

LEGEND	
LIGHTS	
PROPOSED WALL	
EXISTING WALL	
VENT	
SPRINKLER	⊗
FIRE SENSOR	○

GRAPHIC SCALE

50 0 50 100 150 (FEET)

NO.	DESCRIPTION	DATE
	REVISIONS	

REFLECTIVE CEILING PLAN
PORTLAND SPORTS CENTER
WARREN AVENUE PORTLAND, MAINE

FOR:
JIM GRATTELO
PORTLAND SPORTS REALTY, LLC
550 WARREN AVE
PORTLAND, MAINE 04103

ATTAR ENGINEERING, INC.
CIVIL ◆ STRUCTURAL MARINE
1284 STATE ROAD – ELIOT, MAINE 03903
PHONE: (207)439–6023 FAX: (207)439–2128

SCALE: 1" = 50'	APPROVED BY:	DRAWN BY: STB
DATE: 8/26/14		REVISION : DATE – : –
JOB NO: C068–14	CAD FILE: DOME_CEILING	SHEET 1