NEW CONSTRUCTION

EXIST. WALLS

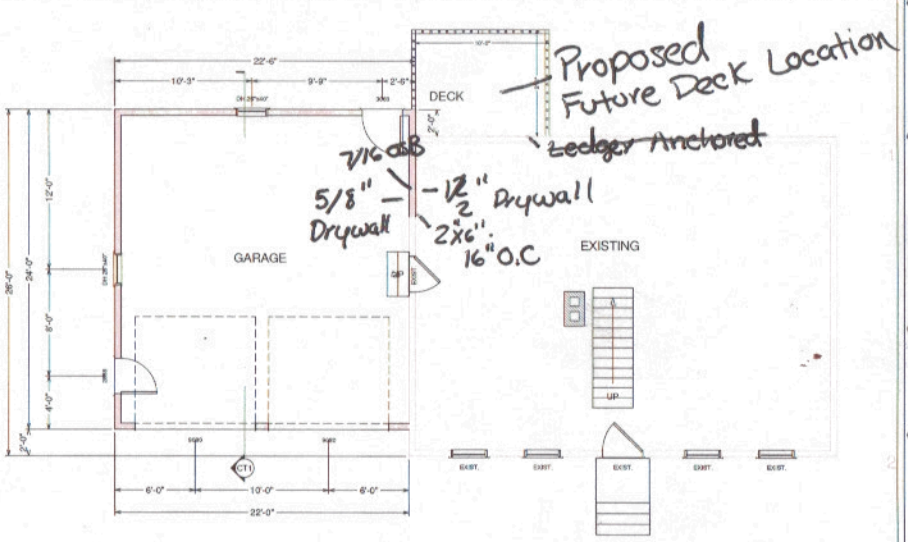

FIRST FLOOR
762 sq ft

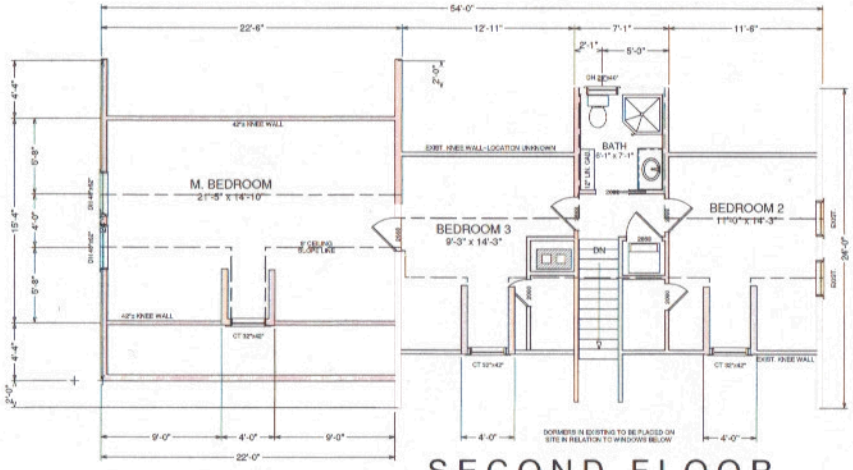

SECOND FLOOR
1011 sq ft

NOTES:

- EXISTING DIMENTIONS ARE APPROXIMATE. PLEASE VERIFY IN FIELD.
- EXISTING STRUCTURE IS SHOWN FOR REPRESENTATION PURPOSES ONLY AND IS NOT MEANT TO BE USED AS AN AS-BUILT DRAWING. ANY VARIATIONS SHOULD BE CONSIDERED INVALID.
- GRADE MAY VARY FROM ACTUAL SITE CONDITIONS

DISCLAIMER

HOME PLANNING CENTER
Drafting & Estimating
Hammond Lumber Company

AD14055
1/20/2015 POR
1/4" = 1'0" 2 of 3

REVISIONS
PRE: 04/28/14
R1: 04/28/14
R2: 10/24/14
R3: 11/06/14
11/10/14
11/11/14
11/13/14
01/19/15

BEP
DJH

24' x 22'
ADDITION

ENVY CONSTRUCTION
AL & CAROL ADDITION

HAMMOND LUMBER COMPANY

12 LOCATIONS TO SERVE YOU BETTER
www.hammondlumber.com

AUBURN · BANGOR · BELGRADE · BOOTHBAY HARBOR · BRUNSWICK · DAMARISCOTTA · FARMINGTON · GREENVILLE · LEWISTON · PORTLAND · SKOWHEGAN