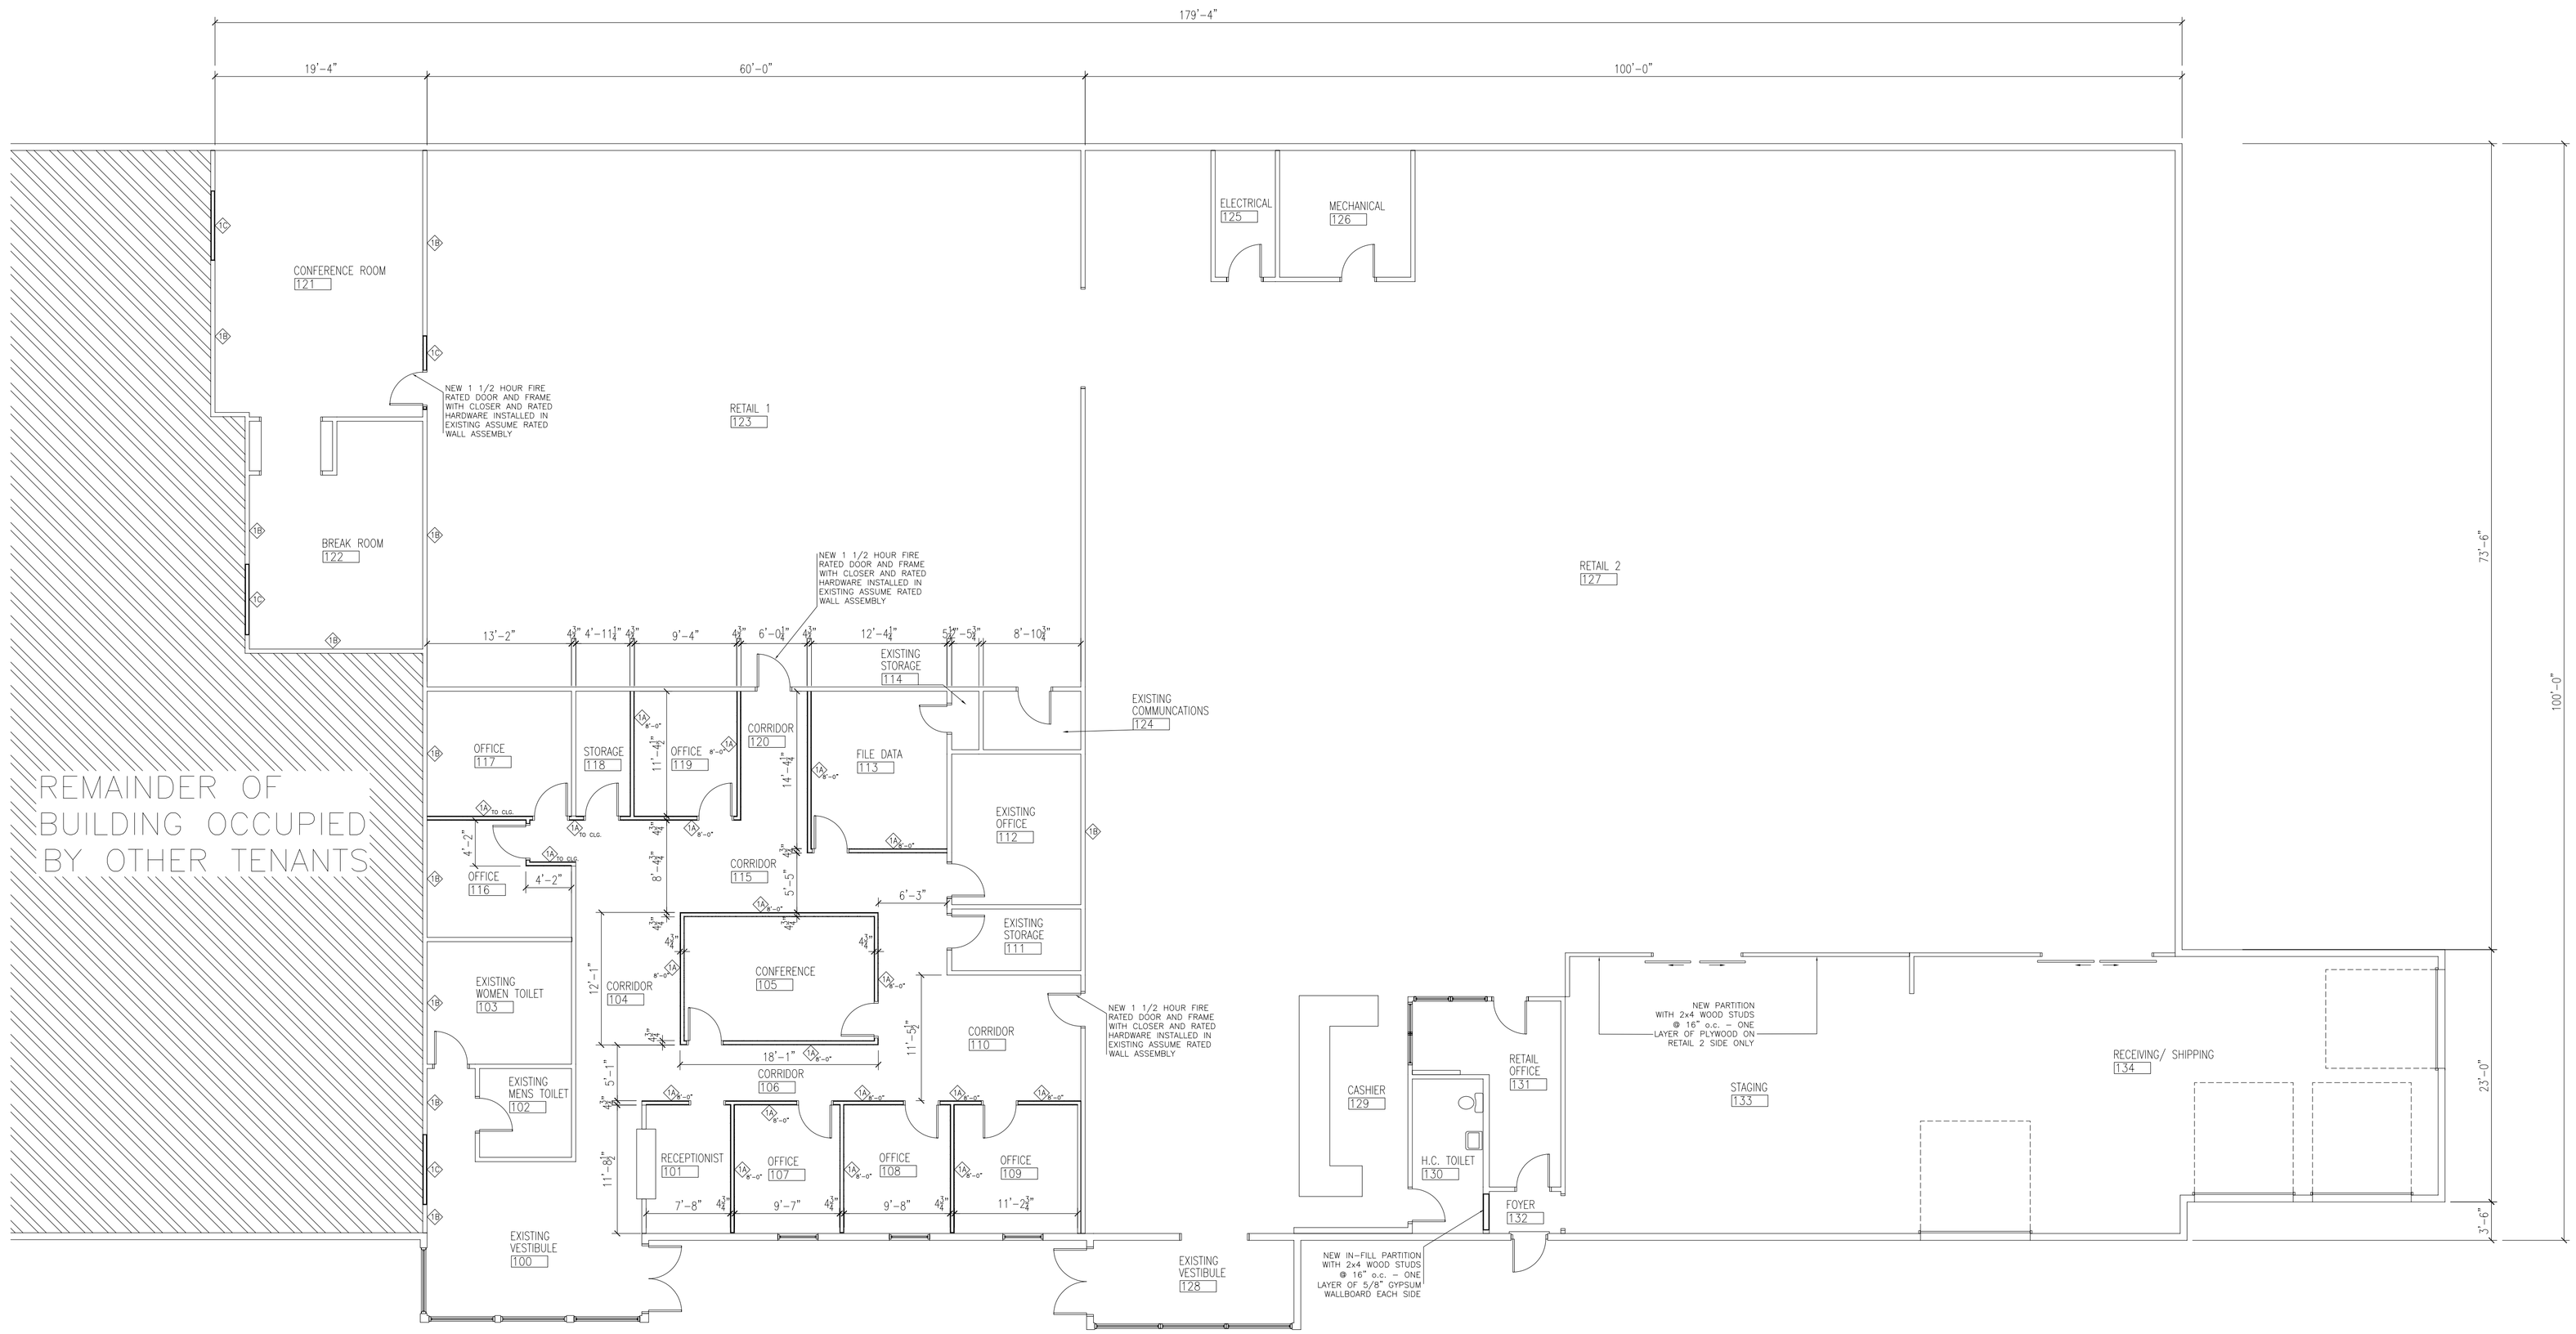

FLOOR PLAN

SCALE: 1/8" = 1'-0"

PARTITION LEGEND

1A (1 HOUR HEIGHT) NEW PARTITION - NON-RATED: 2"x 4" WOOD STUDS @ 16" o.c. MAXIMUM WITH ONE LAYER OF 5/8" GYPSUM WALLBOARD ON EACH SIDE.	
1B EXISTING PARTITION - ASSUMED 1 HOUR FIRE RATED: EXISTING WOOD STUDS @ 16" o.c. MAXIMUM WITH ONE LAYER OF 5/8" GYPSUM WALLBOARD ON EACH SIDE.	
1C NEW IN-FILL PARTITION - 1 HOUR FIRE RATED: NEW WOOD STUDS @ 16" o.c. MAXIMUM WITH ONE LAYER OF 5/8" GYPSUM WALLBOARD ON EACH SIDE.	

John Powers Associates, Inc.
JPA ARCHITECTURE
10 ISLAND AVENUE
CUMBERLAND, MAINE 04021-3043
207-330-8154 VOICE

Revisions	Date	Description
1	11/24/2013	Submission Record Floor Plan

John Powers Associates, Inc.
JPA ARCHITECTURE
10 ISLAND AVENUE
CUMBERLAND, MAINE 04021-3043
207-330-8154 VOICE

PROJECT TITLE

Renovations To 659 Warren Avenue Retail Store

659 Warren, Avenue
Portland, Maine
for
Habitat for Humanity of Greater Portland

SHEET TITLE

FLOOR PLAN - RECORD DRAWING

Date:	November 16, 2013
Scale:	NTS
Drawn By:	JEP
Checked By:	JEP
File Name:	2013.14

GRAPHIC SCALE

A1.1

SHEET No.

© COPYRIGHT
JOHN POWERS ASSOCIATES, INC. 2012
ALL RIGHTS RESERVED