02/12/09 D1-07 DE

REVISE MULTIPURPOSE /TRAINING ROOM TO STANDARD (2) SERVICE ROOM LAYOUT PER SIGN OFF; ADJUST PATIENT SEATING & SQ FOOTAGE CHART ACCORDINGLY; ADJUST WALL SHELV'G & GONDOLA RUNS ACCORDINGLY; UPDATE LINEAL FOOTAGE; REDUCE BOTTLE BAY @ VERIFICATION COUNTER; UPDATE RX LINEAL FOOTAGE; UPDATE PHOTO COUNTER TO CURRENT; UPDATE PHOTO EQUIPMENT TO NEX LAB; REMOVE INK JET REFILL; SHIFT COLUMN LINE "C" 1'-0" TOWARD FRONT OF STORE PER ARCHITECT

12/15/08 D1-06 DE

PER M. ULASZEK: REMOVE 360 BEAUTY BULLPEN AND ADD FLEX BULLPEN ALONG ANGLED WALL, RELO HALLMARK TO BACK AISLES AND REDUCE TO (2) SIDES, SHIFT PROMO AISLE TOWARD BEAUTY & ADD (1) GONDOLA RUN TO FRONT, REDUCE TANDEM CHECKOUT TO (1) CHECKOUT AND ADD (1) CHECKOUT ALONG FRONT WALL, REMOVE (2) 4'-0" WALL SHELV'G SECTIONS ALONG STOCK & ADD FE CU; VERIFIED CARPET TILES & HANGING BEAUTY SIGN W/D. ABBATACOLA

12/08/08 D1-05 DE

REDRAW
REDRAW TO L109X137 IRR; REMOVE ANGLED WALL @ SOUTHWEST CORNER OF BUILD'G PER SITE; ADJUST SHELV'G & SERVICE SPACES ACCORDINGLY

09/17/08 D1-04 DE

ADD VESTIBULE PER P.A.; REVISE CART LAYOUT PER VESTIBULE; CUT BEAUTY WALL BACK 3' TO ACCOMMODATE CART LAYOUT; SHIFT FRONT CHECKOUTS AND ADJUST CARPET TILES ACCORDINGLY; UPDATE 1 HR PHOTO TO SAY PHOTO, FOOD MART TO MARKET & COSMETICS TO BEAUTY UPDATE PHOTO LAYOUT TO PHOTO '08 (VERIFIED W/P.A.); REMOVE E.A.S. SYSTEM @ PASSAGE PER LOSS PREVENTION; UPDATE VERIFICATION WINDOW TO 4'-6"H SILL; ADJUST WALL SHELV'G BELOW TO 48"H; REMOVE VERIFICAITON SHELF PER LOWER SILL; UPDATE PHARMACY INSERTS & EQUIPMENT LAYOUT TO CURRENT WORKFLOW; RELO RX SINK; UPDATE SIGN "P" TO AN ARC; ADD BEAUTY ARC CONFIGURATION; UPDATE INTERIOR HANGING SIGNS TO CURRENT; ADD CEILING HEIGHT CALL OUT BELOW GENERAL SALES; UPDATE 30X48 DUMP TABLE @ FRONT TO VENDOR DUMP TABLE; UPDATE STORE PLANNER LAST NAME TO CURRENT

02/06/08 D1-03 DF

PER P.A.; DRIVE THRU WINDOW MUST BE 4'3"-4" MIN. FROM RIGHT SIDE OF BUILDING PER SITE CONDITIONS; MIRROR RX ORIENTATION & REVISE TO (1) MULTIPURPOSE ROOM; RELO EMPLOYEE ROOM & OFFICE TO RIGHT SIDE OF BLDG & REWORK BATHROOMS ACCORDINGLY; RX VERIFIED W/ARCHANA; WH LOCATION VERIFIED W/PA; ADD DHL TO PHOTO

11/17/08 D1-02 DR

REV MULTI-PURPOSE & TRAINING ROOMS TO GAIN MORE SPACE IN STOCK PER SIGN OFF REVS; ADJUST SQUARE FOOTAGE ACCORDINGLY; ADD 3' GONDOLA SIGN OFF REVS; UPDATE CONSULT CNTR TO CURRENT

12/21/07 D1-01 DR

NO COMPACTORS PER SITE CONDITIONS; CARPET TILES PER REGION; STILL WAITING ON MERCHANDISING VERIFICATION

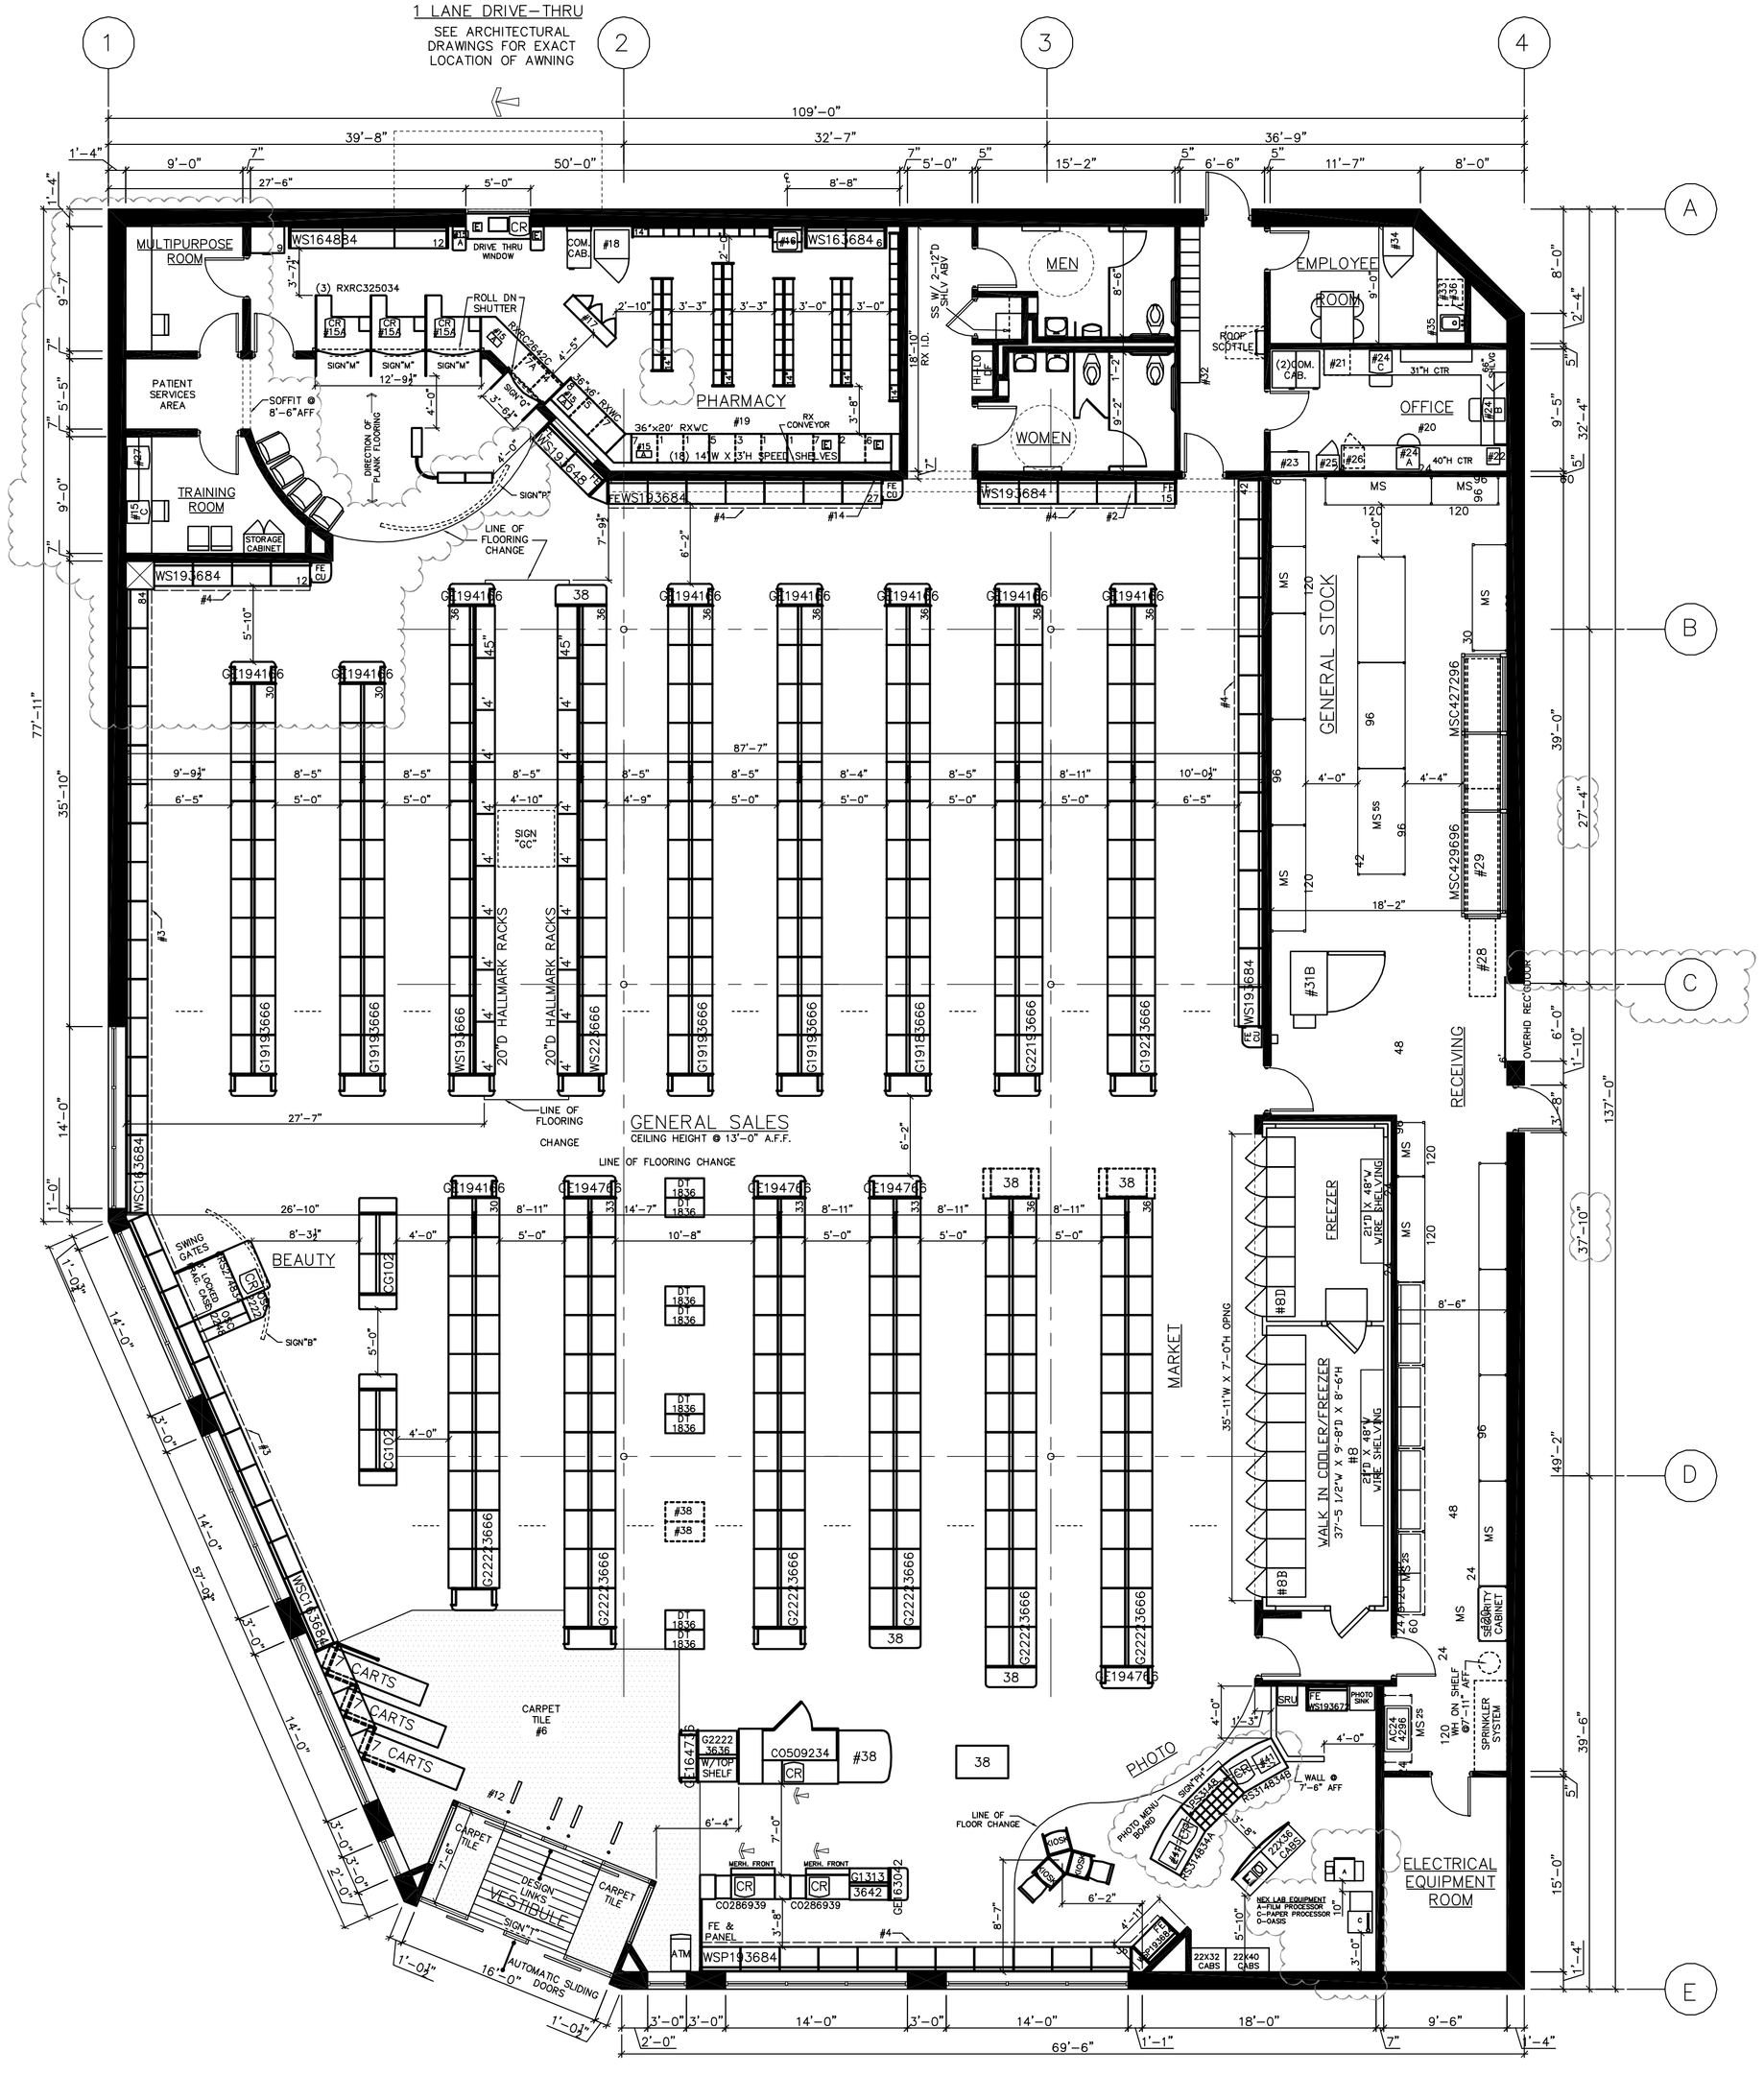

INTERIOR HANGING SIGNS

GENERAL SALES AREA:
ALL SIGNS @ 10'-6" TO BOTTOM OF SIGN UNLESS OTHERWISE NOTED.
AISLE MARKERS @ 9'-6" TO BOTTOM OF SIGN.

SIGN "B" BEAUTY SIGN (9'-4" TO BOTTOM OF SIGN)
SIGN "L" LIQUOR / THANK YOU
SIGN "PH" PHOTO SIGN (9'-4" TO BOTTOM OF SIGN)
SIGN "T" STORE HOURS SIGN
SIGN "GC" GREETING CARD SIGN
SIGN "D" DOWNTOWN CHECKOUT LANE #
SIGN "CA" CALIFORNIA ACCESSIBILITY SIGN (6'-0" TO BOTTOM OF SIGN)
SIGN "ADA" SYMBOL OF ACCESSIBILITY

PHARMACY DEPARTMENT:
REFER TO FIXTURE PLAN FOR REQUIRED SIGNS
SIGN "J" PICK-UP WINDOW
SIGN "K" DROP OFF WINDOW
SIGN "M" DROP OFF/PICK UP SIGN
SIGN "P" PHARMACY SIGN (9'-4" TO BOTTOM OF SIGN)
SIGN "O" CONSULTATION WINDOW
SIGN "TX" T. A. S.
ATTACH SIGNS TO UNDERSIDE OF CASED OPENINGS. REFER TO FIXTURE PLAN FOR SIGN LOCATION. PROVIDE (2) HOLLOW WALL ANCHORS PER SIGN. SCREW THREADED EYEBOLT INTO ANCHOR. HANG SIGNS FROM EYEBOLTS WITH "S" HOOKS.

GENERAL NOTES

GENERAL SALES AREA:
1. PLEASE PROVIDE PROPER A.D.A. CLEARANCES ON BOTH SIDES OF ALL DOORS
2. MIRROR ON REAR WALL
3. BEAUTY CORNICE
4. SALES AREA CORNICE (FIXTURE MOUNTED)
5. PHOTO CORNICE (FIXTURE MTD UNLESS NOTED)
6. CARPET TILES & DESIGN LINKS FURNISHED AND INSTALLED BY WALGREENS (WHEN SHOWN)
7. MASTER-BILT REACH-IN REFRIGERATION:
   MODEL TEM - ENDLESS REACH-IN REFRIGERATORS AND MODEL TEL - ENDLESS REACH-IN FREEZERS (ADD 2" AT EACH END, FOR END PANELS)
   A. __ TEM-3-24: 74 1/4"W X 37 3/4"D X 80"H
   B. __ TEL-3-24: 74 1/4"W X 37 3/4"D X 80"H
   BMG/BLG SERIES - SELF CONTAINED REFRIGERATORS AND FREEZERS
   C. __ BMG-74: 78"W X 35 3/8"D X 79"H
   D. __ BLG-74: 78"W X 35 3/8"D X 79"H
   SMB SERIES - SELF CONTAINED SLIDING DOOR REFRIGERATORS
   E. __ SMB-580: 70"W X 32 1/4"D X 76 1/2"H
   BACK-UP REFRIGERATORS AND FREEZERS
   F. __ TAC-48HD: 52"W X 35 3/4"D X 80 1/2"H
   G. __ TAF-48HD: 52"W X 35 3/4"D X 80 1/2"H
8. MASTER-BILT WALK-IN COOLER: PROVIDE
   9 #1000R COOLMASTER DOORS
   26 3/4" X 73" EACH AND
   6 #100FR FREEZEMASTER DOORS
   26 3/8" X 73" EACH BY ANTHONY
   A. __ DOOR(S): FOR EACH DOOR PROVIDE (7) __"D BEV-O-FLOW GRAVITY SHELVES; UPPER (5) WITH SLIDES AND LOWER (2) WITH ROLLERS COMPLETE WITH UPRIGHTS
   B. 9 DOOR(S): FOR EACH DOOR PROVIDE 36"D B-O-F NYLA-LITE SHELVING SYSTEM
   C. __ DOOR(S): __"D ROLLER CONVEYOR AT FLOOR LEVEL
   D. 6 DOOR(S): FOR EACH DOOR PROVIDE 27"D ANTHONY SHELVES
   E. __ DOOR(S): FOR EACH DOOR PROVIDE (2) 27"D ANTHONY SHELVES AND (4) 36"D MERCHANDISER SHELVES
   F. __ DOOR(S): __"D DOUBLE DECK ROLLER CONVEYOR
9. ICE CHEST BY VENDOR
10. CART RAILS W/ DISPLAY SHELF & SLAT WALL ABOVE
11. PROVIDE A 6"H BLACK VINYL BASE AT ALL CHECKOUTS
12. ELECTRONIC ARTICLE SURVEILLANCE SYSTEM

PHARMACY DEPARTMENT:
13. PATIENT SEATING AREA: (4) SEATS & TRAFFIC CONTROL FIXTURE
14. PROVIDE FRAMING FOR 3'-6"W X 7'H OPENING FOR FUTURE DROP-OFF WINDOW
15. COMPUTER TERMINAL
    15A: INTERCOM PLUS TERMINAL
    15C: TRAINING TERMINAL (IN TRAINING ROOM)
16. RX SINK AND CABINET
17. CRX CABINET
18. RX REFRIGERATOR
19. PROVIDE A CARPETED FLOOR WITH A RUBBER RUNNER. RX UNDERCOUNTER INSERTS:
    #1 - RX 3 DRAWER VIAL INSERT
    #2 - RX 3 DRAWER FILE INSERT
    #3 - RX OPEN INSERT
    #4 - RX CONSULTATION COUNTER UNIT
    #5 - RX PRINTER INSERT
    #6 - RX 5 DRAWER FILE INSERT
    #7 - RX OPEN INSERT WITH CPU SHELF (39"H CNTR)
    #7A - RX OPEN INSERT WITH CPU SHELF (34"H CNTR)
    #8 - RX OPEN CABINET (39"H CNTR)
    #9 - RX 10 DRAWER FILE CABINET

OFFICE:
20. PROVIDE TILED FLOOR & VINYL WALLCOVERING
21. UNDER COUNTER SHELF UNIT
22. PRINTER
23. LATERAL FILE
24. OFFICE COMPUTERS
    24A: P.O.S. TERMINAL
    24B: AS400 TERMINAL
    24C: OFFICE P.C.
25. TILL LOCKER
26. SAFE
27. TV & VCR (IN TRAINING ROOM)

STOCKROOM:
28. NEST-A-FLEX CONVEYOR
29. GRAVITY CONVEYOR
30. POWER ROLLER CONVEYOR
31. SEE ARCHITECTURAL DRAWINGS FOR EXACT LOCATION & POSITIONING OF COMPACTORS
    31A: TRASH COMPACTOR
    31B: BALER
    31C: CARDBOARD COMPACTOR

EMPLOYEE ROOM:
32. EMPLOYEE LOCKERS: (1) 48" W COAT LOCKER W/ PERFORATED DOORS, (6) 6 TIER BOX LOCKERS & (6) ADA LOCKERS W/ SAFETY VIEW DOORS
33. 5'-0"W X 2'-2"D EMPLOYEE COUNTER W/ (1) CABINET/S
34. EMPLOYEE ROOM REFRIGERATOR (PROVIDE 32" CLEARANCE WHEN NEXT TO COUNTER)
35. EMPLOYEE ROOM SINK (IN COUNTER)
36. 4'-0" MIRROR CENTERED ON WALL ABOVE COUNTER

MISCELLANEOUS:
37. "E" - ELECTRICAL OUTLET FOR FUTURE USE
38. VENDOR RACKS: REMOVE BASE DECK & SHOES; (END PANEL TO REMAIN)
39. PROVIDE OPENING FOR ONE-WAY GLASS (SEE INTERIOR ELEVATION FOR LOCATION)
40. NEWSPAPER RACK BY VENDOR
41. PICTURE CARE PLUS TERMINAL

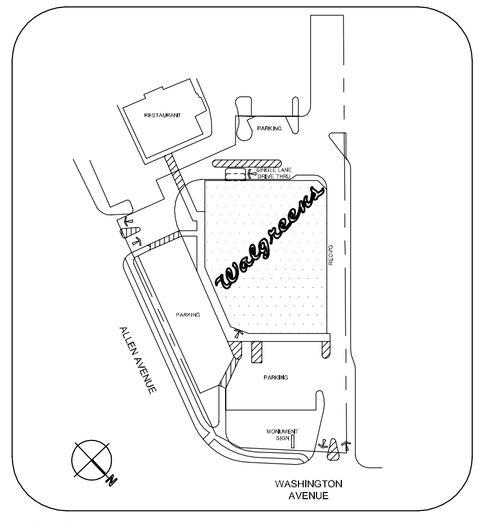

KEY PLAN NOT TO SCALE — FOR REFERENCE ONLY: SEE CONTRACT DOCUMENTS FOR DETAILED SITE PLAN

TOTAL BY LINEAL FOOTAGE	1,299 LN. FT
FRONT WALL SHELVING	36 LN. FT.
BEAUTY WALL SHELVING	84 LN. FT.
REMAINING WALL SHELVING (BACK & SIDE WALL, RX SEATING)	96 LN. FT.
BACK GONDOLAS	552 LN. FT.
FRONT GONDOLAS	402 LN. FT.
HALLMARK SHELVING	72 LN. FT.
BEAUTY GONDOLAS	24 LN. FT.
COOLERS	20 LN. FT.
FREEZERS	13 LN. FT.

* A.D.A DOOR CLEARANCES

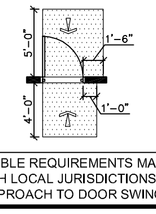

*ACCESSIBLE REQUIREMENTS MAY VARY WITH LOCAL JURISDICTIONS & APPROACH TO DOOR SWING

EXECUTIVE APPROVAL		DATE
SENIOR VICE PRESIDENT FACILITIES DEVELOPMENT		
SENIOR VICE PRESIDENT STORE OPERATIONS	HANDAL	
VICE PRESIDENT STORE OPERATIONS	ARNOULT	01/05/09
REVIEWED BY:	E. BAUERS (12/08/08)	D. PRATT (12/05/08)

FIXTURE LEGEND

G GONDOLA (EA. SIDE)	1818 D.	36 W.	66 * H.
GE GONDOLA END	18 D.	39 W.	66 * H.
WS WALL SHLVG	18 D.	36 W.	84 * H.

ALL OTHER FIXTURES ARE TYPICALLY CALLED OUT DEPTH BY WIDTH. EXAMPLE:

DT DISPLAY TABLE	30 D.	48 W.

*DOES NOT INCLUDE STANDARDS, WOOD GROUNDS OR FINISHED END PANELS

Walgreens

FACILITIES PLANNING, DESIGN, & ENGINEERING
106 WILMOT ROAD
DEERFIELD, IL 60015-5105

PROJECT DATA

TYPE		GENERAL SALES	■	MARKET	■
NEW LOCATION	■	PHARMACY	■	SECURITY	$
NEW LOCATION EXIST'G BLDG	□	PHOTO	■	24 HOUR STORE	□
REMODEL	□	LIQUOR	□	OTHER	□

SQUARE FOOT AREA SUMMARY

DEPARTMENT		SALES	STOCK	SERVICE	TOTAL EXIST'G	TOTAL NEW
GEN SALES	NEW	8436	2,095	1203		11,734
	EXIST'G					
FOOD MART	NEW	900				900
	EXIST'G					
RX	NEW	728				728
	EXIST'G					
RX WAIT'G	NEW	299				299
	EXIST'G					
PHOTO	NEW	435				435
	EXIST'G					
LIQUOR	NEW					
	EXIST'G					
BSMT	NEW					
	EXIST'G					
2ND FLOOR	NEW					
	EXIST'G					
TOTAL NEW		10,798	2,095	1,203		14,096
TOTAL EXST'G						

TOTAL AREA: FIRST FLOOR 14,096 SQ.FT.
TOTAL AREA: OTHER LEVELS ____ SQ.FT.
GROSS AREA INCLUDING ALL DEPARTMENTS & ALL LEVELS: 14,096 SQ.FT.
RX SHELVING LINEAL FEET: 88 LN.FT.

NO.	DATE	BY	DESCRIPTION	CONST

REVISIONS

CERTIFICATION AND SEAL

I HEREBY CERTIFY THAT THIS PLAN AND SPECIFICATION WAS PREPARED BY ME OR UNDER MY DIRECT SUPERVISION AND THAT I AM A DULY REGISTERED ARCHITECT OR ENGINEER UNDER THE LAWS OF THE STATE OF MAINE AS SIGNIFIED BY MY HAND AND SEAL.

STORE NUMBER 12326

PROJECT NAME
WALGREENS STORE
(SWC) WASHINGTON AVE & ALLEN AVE
PORTLAND, MAINE

DRAWING TITLE
FIXTURE FLOOR PLAN

CADD PLOT: 12326-D1-07-12FEB09
VOID PLOT: 12326-D1-06-15DEC08
SUPERSEDES PLAN DATED: 12/21/07

SCALE: 1/8"=1'-0"
DRAWN BY: D. ERICKSON
DATE: 12/08/08
REVIEWED BY: L. CUMMINGS

DRAWING NO. D1
OF DWGS.

DANIELLE ERICKSON 2/12/2009 9:41 AM F:\JOBS\DANIELLE\12326-D1-07-12FEB09