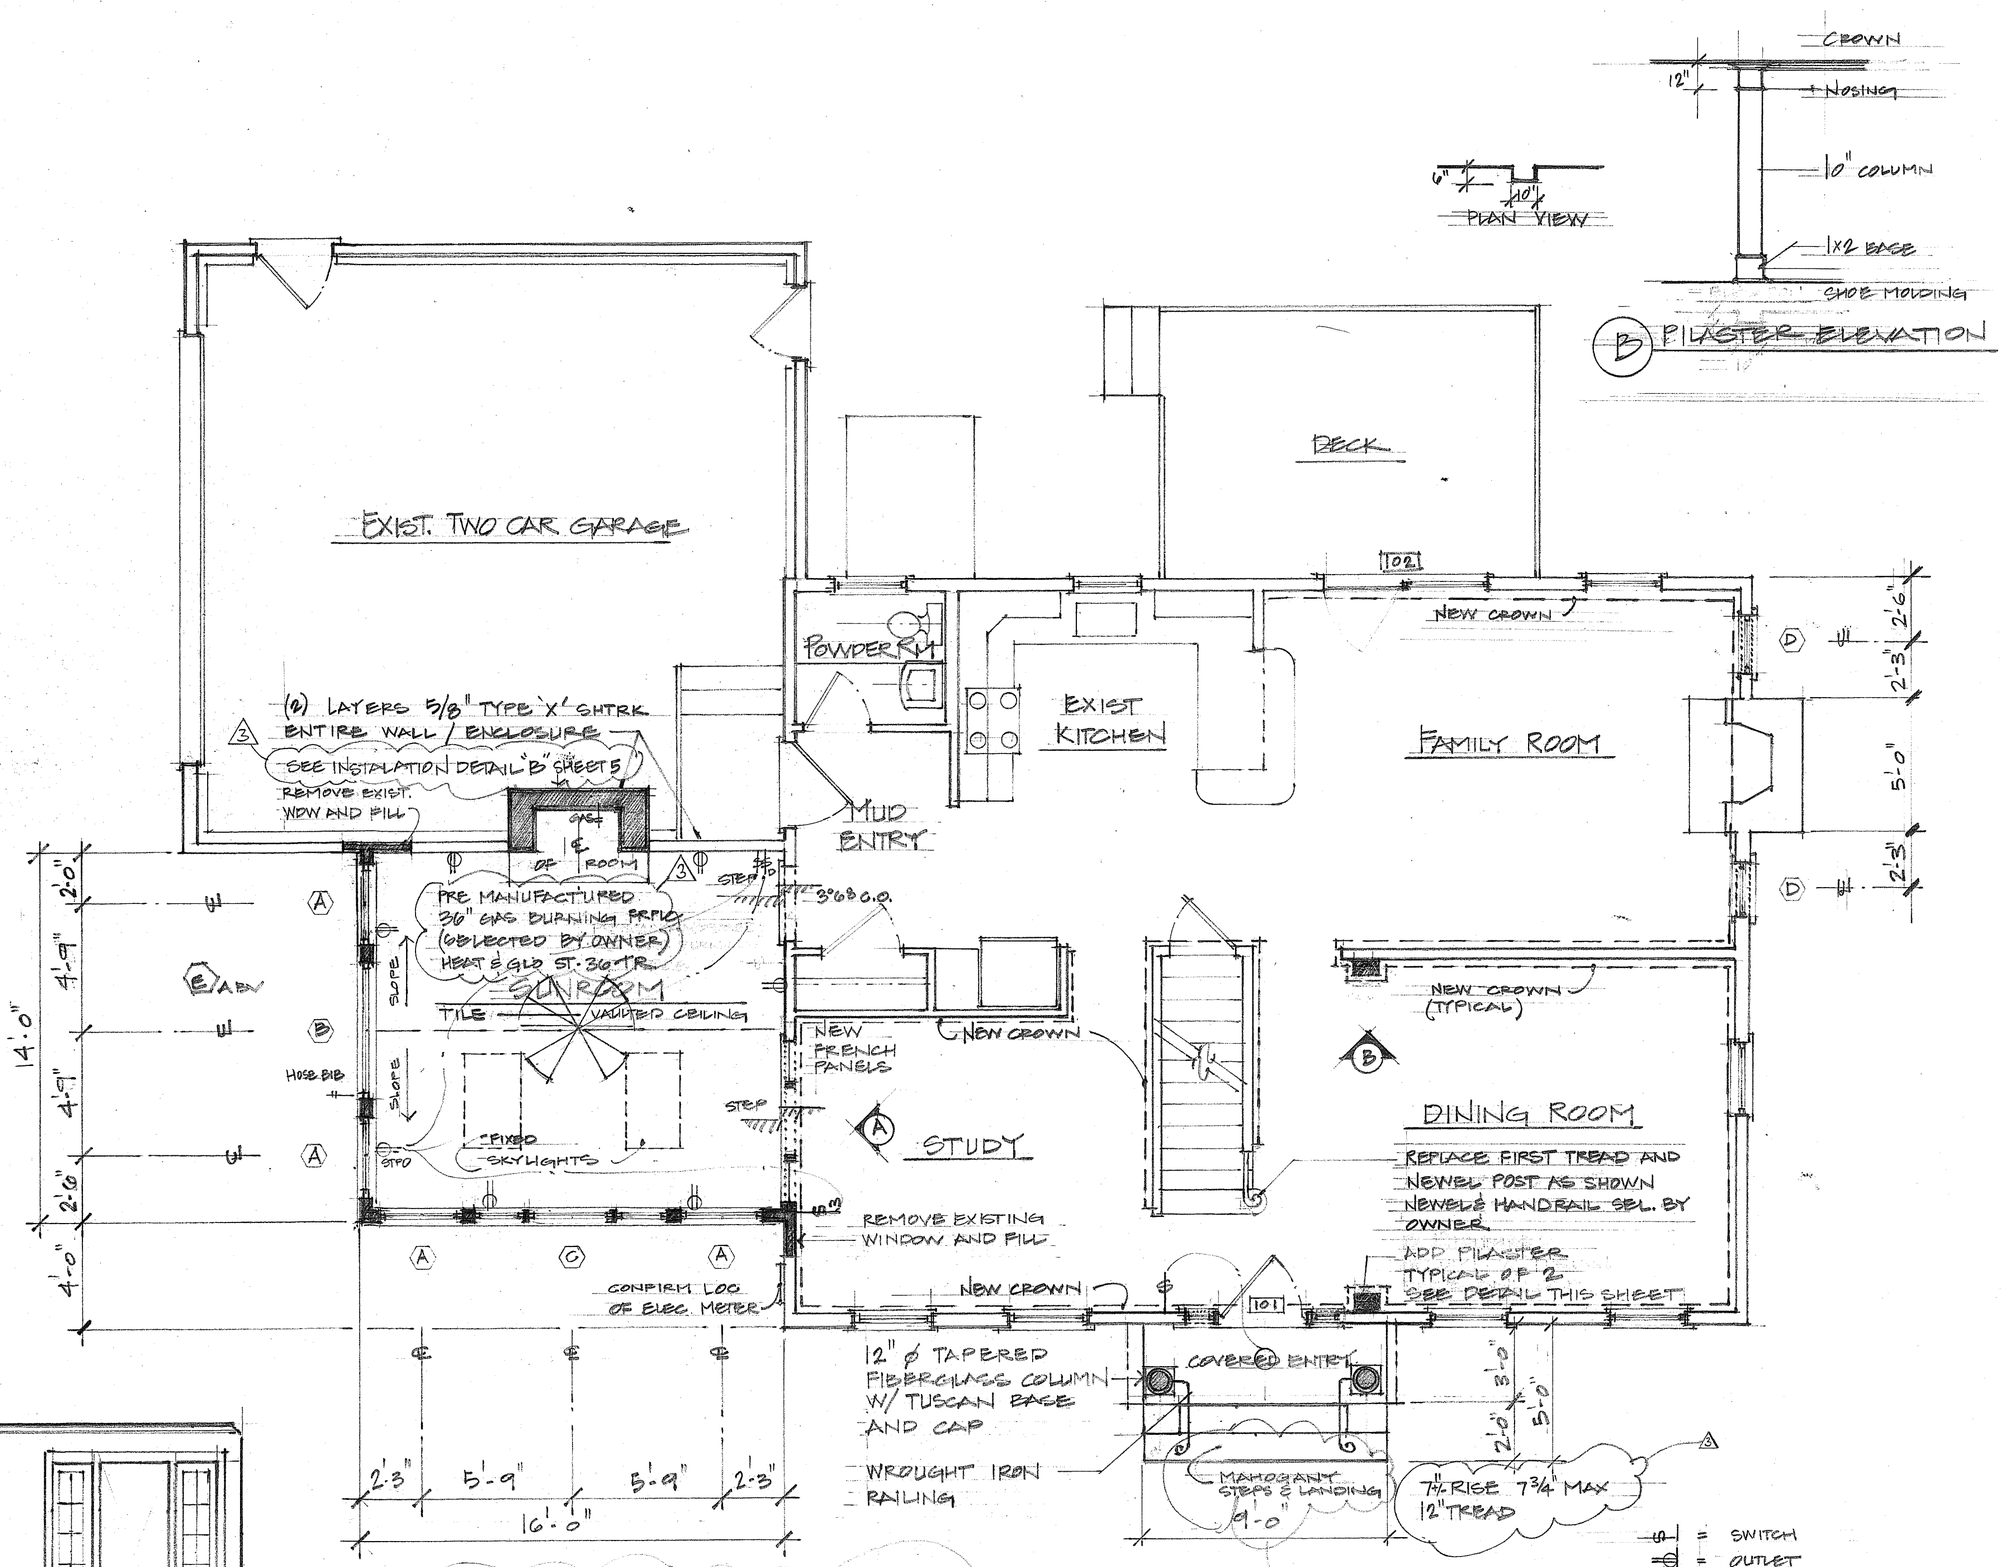

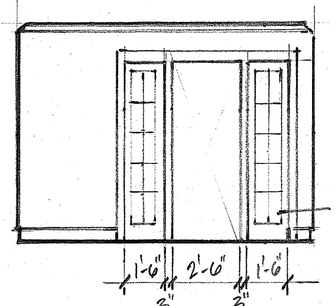

A FRENCH PANELS ELEVATION

WINDOW SCHEDULE

LABEL	QUANTITY	WINDOW	NOTES
A	4	244DH3056	
B	1	244FX5056	
C	1	244DH1856/244DH3556/244DH1856	MULLED
D	2	244DH2036	
E	1	244FX1820	
102	1	6'-0"X6'-8" SLIDER	6'-10" TALL IF IT FITS

ANDERSEN 200 SERIES WHITE EXTERIOR
PRIMED INTERIOR
GRILLS BETWEEN THE GLASS

FIRST FLOOR PLAN

SCALE 1/4" = 1'-0"

COPYRIGHT 2015
PETERSON DESIGN GROUP
Reuse or reproduction of the contents of this document is not permitted without written permission of PETERSON DESIGN GROUP.
Peterson Design Group is a subsidiary of Erika C. Peterson Custom Residential Design, Inc.

PETERSON DESIGN GROUP
ARCHITECTURE
5 Nason Ct., Suite 5, Village Green
Kennebunk, Maine 04043
Tel. 207-985-1526 Fax 207-985-1527
10 Dana Street, Suite 201
Portland, Maine 04101
Tel. 207-775-3399 Fax 207-775-3393
info@petersondesigngroup.us

ADDITION AND RENOVATION FOR:
JORDAN RESIDENCE
ROARING BROOK ROAD * PORTLAND, MAINE

DRAWN BY:	E.H.L.
CHECKED BY:	
JOB NO.:	1445
DATE:	MARCH 2 2015 △1 MARCH 4, 2015 △2 APRIL 1 2015 △3 APRIL 30 2015 △5 MAY 12 2015
SHEET NO.:	2